
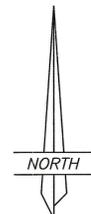


**"AS-BUILT" PIPELINE LOCATION SURVEY FOR
ELPASO E&P COMPANY, L.P.
SECTIONS 12 & 13, TOWNSHIP 1 SOUTH, RANGE 2 WEST
UINTAH SPECIAL BASE AND MERIDIAN**

LINE	BEARING	DISTANCE
L1	N 16°09'32" E	106.39'
L2	N 00°13'09" W	419.50'
L3	S 89°03'31" E	123.39'
L4	N 00°02'22" W	43.03'
L5	N 89°35'44" E	163.50'

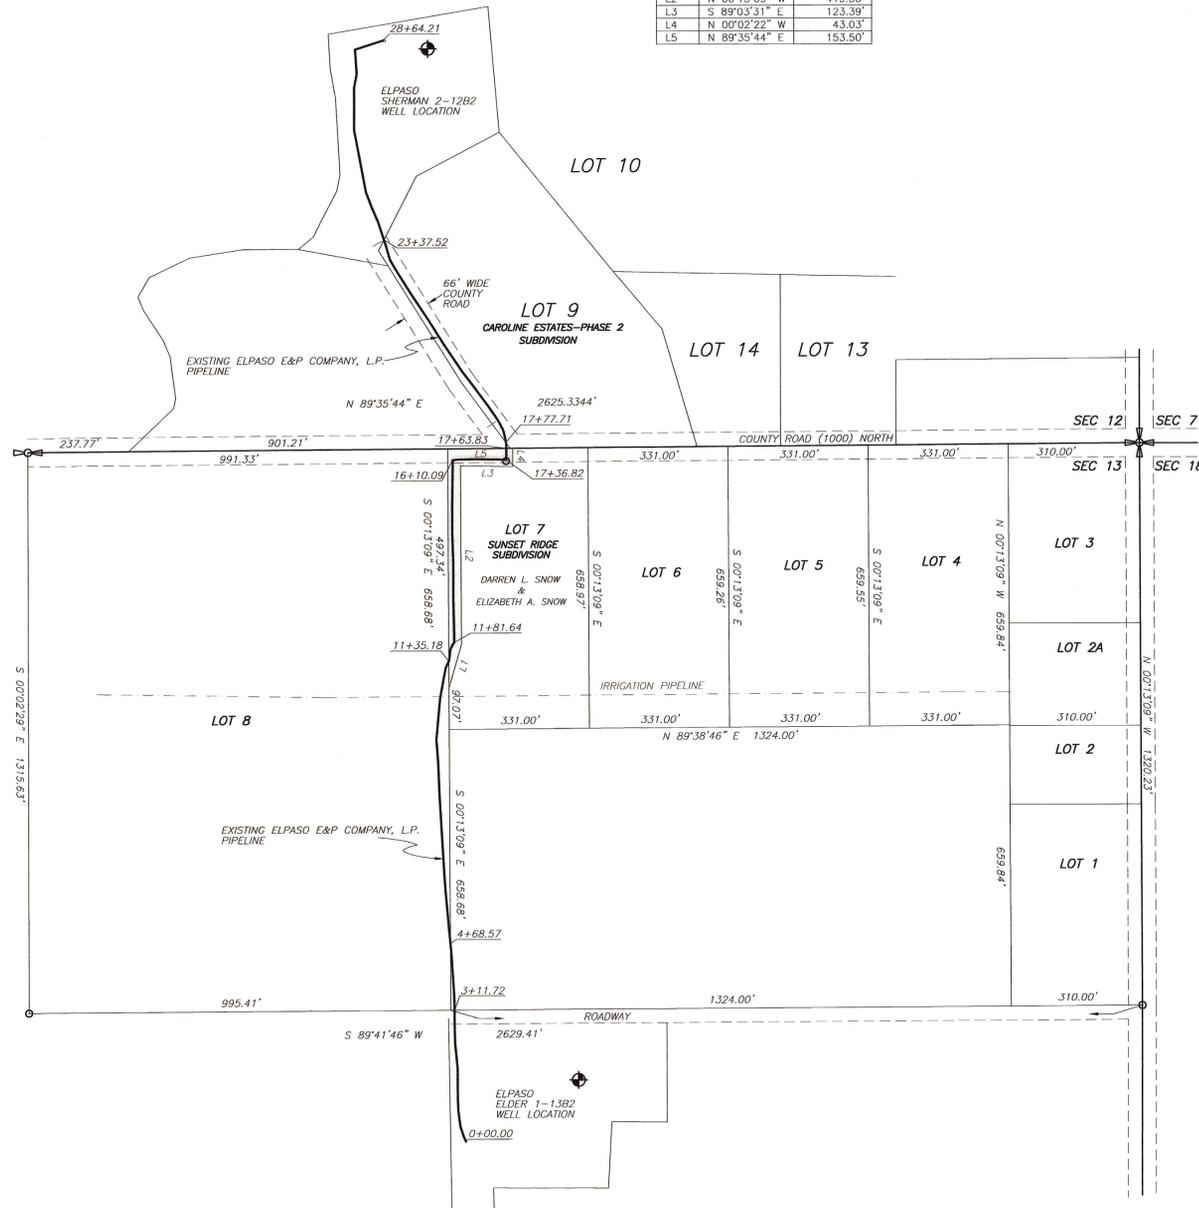

LEGEND AND NOTES


- FOUND R/R SPIKE AT SECTION CORNER
- FOUND MONUMENT SPIKE AT 1/16 CORNER
- FOUND COUNTY ALUM MONUMENT AT 1/4 CORNER FROM TIES OF A PREVIOUS SURVEY
- ROAD RIGHT-OF-WAY LINES

THIS SURVEY WAS PERFORMED USING GLOBAL POSITIONING SYSTEM EQUIPMENT AND PROCEDURES. THE BEARINGS ARE BASED ON WGS 84 DATUM.

ADDRESSES MAY VARY FROM SHOWN VALUES, DEPENDING ON FINAL LOCATION OF HOUSES

SURVEYOR'S CERTIFICATE

This is to certify that this plat was prepared from the field notes and electronic data collector files of an actual survey made by me, or under my personal supervision, of the parcel of land shown hereon, and that the monuments indicated were found or set during said survey, and that this plat accurately represents said survey to the best of my knowledge.

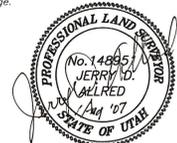

Jerry D. Allred, Professional Land Surveyor,
Certificate No. 148951, (Utah)

COUNTY RECORDER'S CERTIFICATE

STATE OF UTAH }
COUNTY OF DUCHESNE } SS

THIS IS TO CERTIFY THAT THIS PLAT WAS FILED FOR RECORD IN THE COUNTY RECORDER'S OFFICE ON THE _____ DAY OF _____, 20____, AT _____ O'CLOCK ____M, AND IS DULY RECORDED.

FILING NO. _____ COUNTY RECORDER _____

Co. Surveyor File # 1912

