



PROPERTY SURVEY FOR
JIM BILLS
 SECTION 25, TOWNSHIP 1 SOUTH, RANGE 5 WEST
 UINTAH SPECIAL BASE AND MERIDIAN

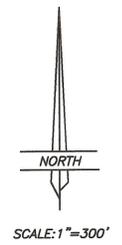

SCALE: 1"=300'

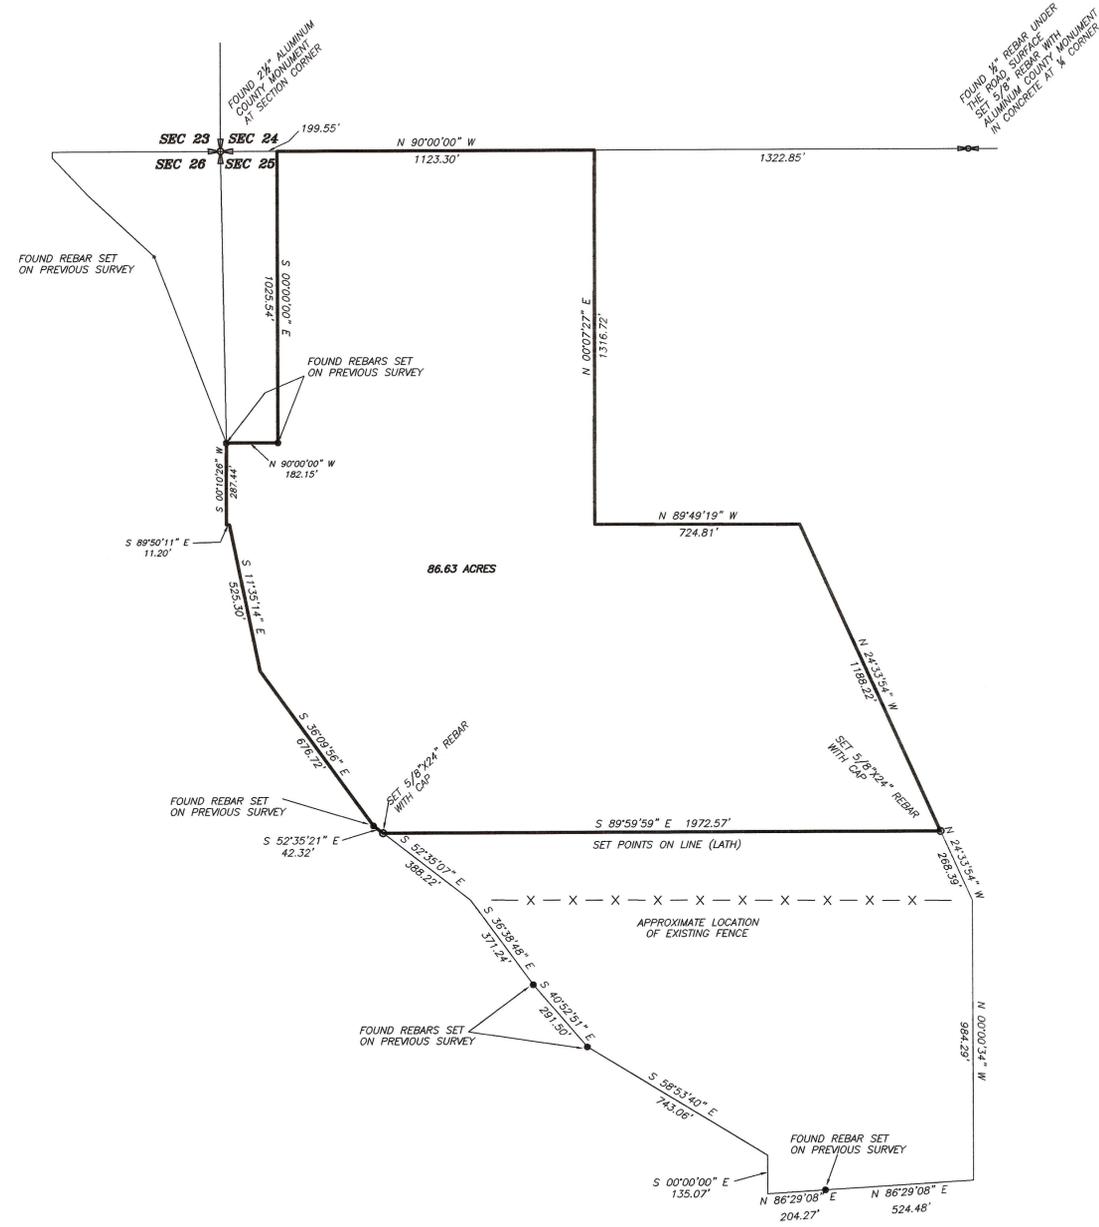

NARRATIVE

This survey was requested by Mr. Jim Bills for the purpose of marking the boundary lines of the parcel of property shown on this plat. Several 1/2" rebar set on previous surveys marking the parcel boundary were found as shown. The Northwest Section Corner was found as referenced in the Duchesne County Surveyor's office. A PK nail was set in the asphalt surface of the county road approximately 0.2 feet Northeast of the North Quarter Corner. The iron pin referenced in the County Surveyor's records was found buried under the asphalt surface. An aluminum county monument was installed on the rebar flush with the road surface. The boundary of the parcel was determined from deed records and the records of previous surveys and marked as shown.

THIS SURVEY WAS PERFORMED USING G.P.S. (GLOBAL POSITIONING SYSTEM) PROCEDURES AND EQUIPMENT. THE BASIS OF BEARINGS WAS BASED ON WGS-84 DATUM.

SURVEYOR'S CERTIFICATE

This is to certify that I have surveyed the parcel of land shown on this plat, and that the monuments indicated were found or set during said survey, and that this plat accurately represents said survey to the best of my knowledge.



Jerry D. Allred, Licensed Land Surveyor,
 Certificate 148951 (Utah)

County Surveyor's File # 1307

JERRY D. ALLRED & ASSOCIATES
 SURVEYING CONSULTANTS
 121 NORTH CENTER ST., - P.O. BOX 975
 DUCHEсне, UTAH 84021
 (435) 736-5357