

T2S, R3W, U.S.B.&M.

ANR PRODUCTION CO.

**AS-BUILT
SALT WATER DISPOSAL
PIPELINE RIGHT-OF-WAY**

LOCATED IN
SECTION 1, T2S, R3W, U.S.B.&M.
DUCHESE COUNTY, UTAH

S89°49'01"E - 5264.60' (Meas.)

5/8" Rebar on
East/West Fence
Line

Duchesne County
Alum. Cap
Steel Post
Pile Stones


DESCRIPTION

A 33' WIDE RIGHT-OF-WAY 16.5' ON EACH SIDE OF THE FOLLOWING DESCRIBED CENTERLINE.

BEGINNING AT A POINT ON THE EAST LINE OF THE SW 1/4 OF SECTION 1, T2S, R3W, U.S.B.&M. WHICH BEARS N70°34'53"W 2804.42' FROM THE SOUTHEAST CORNER OF SAID SECTION, THENCE S77°12'13"W 146.37'; THENCE S67°10'45"W 111.84'; THENCE S76°20'58"W 191.04'; THENCE N70°44'47"W 136.64'; THENCE N89°00'48"W 520.93' TO A POINT IN THE SAID SW 1/4 WHICH BEARS N60°32'48"E 1801.97' FROM THE SOUTHWEST CORNER OF SAID SECTION. THE SIDE LINES OF SAID DESCRIBED RIGHT-OF-WAY BEING SHORTENED OR ELONGATED TO MEET THE GRANTOR'S PROPERTY LINES. BASIS OF BEARINGS IS THE EAST LINE OF SAID SECTION WHICH IS ASSUMED FROM G.L.O. INFORMATION TO BEAR NORTH. LENGTH OF RIGHT-OF-WAY IS 1,106.82' OR 67.08 RODS. CONTAINS 0.84 ACRES MORE OR LESS.

NR.	BEARING	TANGENT
T1	S77°12'13"W	146.37'
T2	S67°10'45"W	111.84'
T3	S76°20'58"W	191.04'
T4	N70°44'47"W	136.64'

▲ = SECTION CORNERS LOCATED.

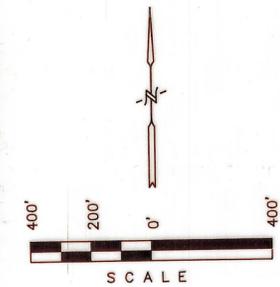

SURVEYOR'S NARRATIVE

WE WERE CONTACTED BY ANR PRODUCTION CO. & REQUESTED TO SURVEY AN AS-BUILT RIGHT-OF-WAY FOR A SALT WATER DISPOSAL PIPELINE FROM AN EXISTING VALVE BOX IN THE SE 1/4 OF SECTION 1, T2S, R3W, U.S.B.&M. TO AN EXISTING LINE IN THE SW 1/4 OF SAID SECTION. AS CONTROL FOR THIS SURVEY WE USED THE SECTION CORNERS SHOWN HEREON. THE LOCATION OF THE EAST LINE OF THE SE 1/4 SW 1/4 WAS ESTABLISHED USING THE THREE MILE METHOD OF SECTION BREAKDOWN.

CERTIFICATE

THIS IS TO CERTIFY THAT THE ABOVE PLAT WAS PREPARED FROM FIELD NOTES OF ACTUAL SURVEYS MADE BY ME OR UNDER MY SUPERVISION AND THAT THE SAME ARE TRUE AND CORRECT TO THE BEST OF MY KNOWLEDGE AND BELIEF.

3137
LAWRENCE D. KEYS
REGISTERED LAND SURVEYOR
REGISTRATION NO. 3137
STATE OF UTAH

30 Dec '91 Duch Co Sur File #179


UEIS UTAH ENGINEERING & LAND SURVEYING PHONE: (801) 789-1017 85 SOUTH 200 EAST - VERNAL, UTAH 84078	
SCALE: 1" = 400'	DATE: 12-19-91
SURVEYED BY: D.A. K.L.	DRAWN BY: T.D.H.
WEATHER:	FILE: 31050

COUNTY SURVEYOR'S CERTIFICATE

THE DUCHESE COUNTY SURVEYOR HAS CHECKED THIS PLAT FOR FORM AND ADHERANCE TO THE STATE OF UTAH REQUIREMENTS FOR ITEMS TO BE ON A SURVEYOR'S PLAT FOR RECORDING WITH THE COUNTY SURVEYOR'S OFFICE, ON THIS _____ DAY OF _____, 19__.

THE DUCHESE COUNTY SURVEYOR

FILE NO. _____ FEE PAID \$_____ AT THE REQUEST OF UTAH ENGINEERING AND LAND SURVEYING, THIS _____ DAY OF _____, 19__.

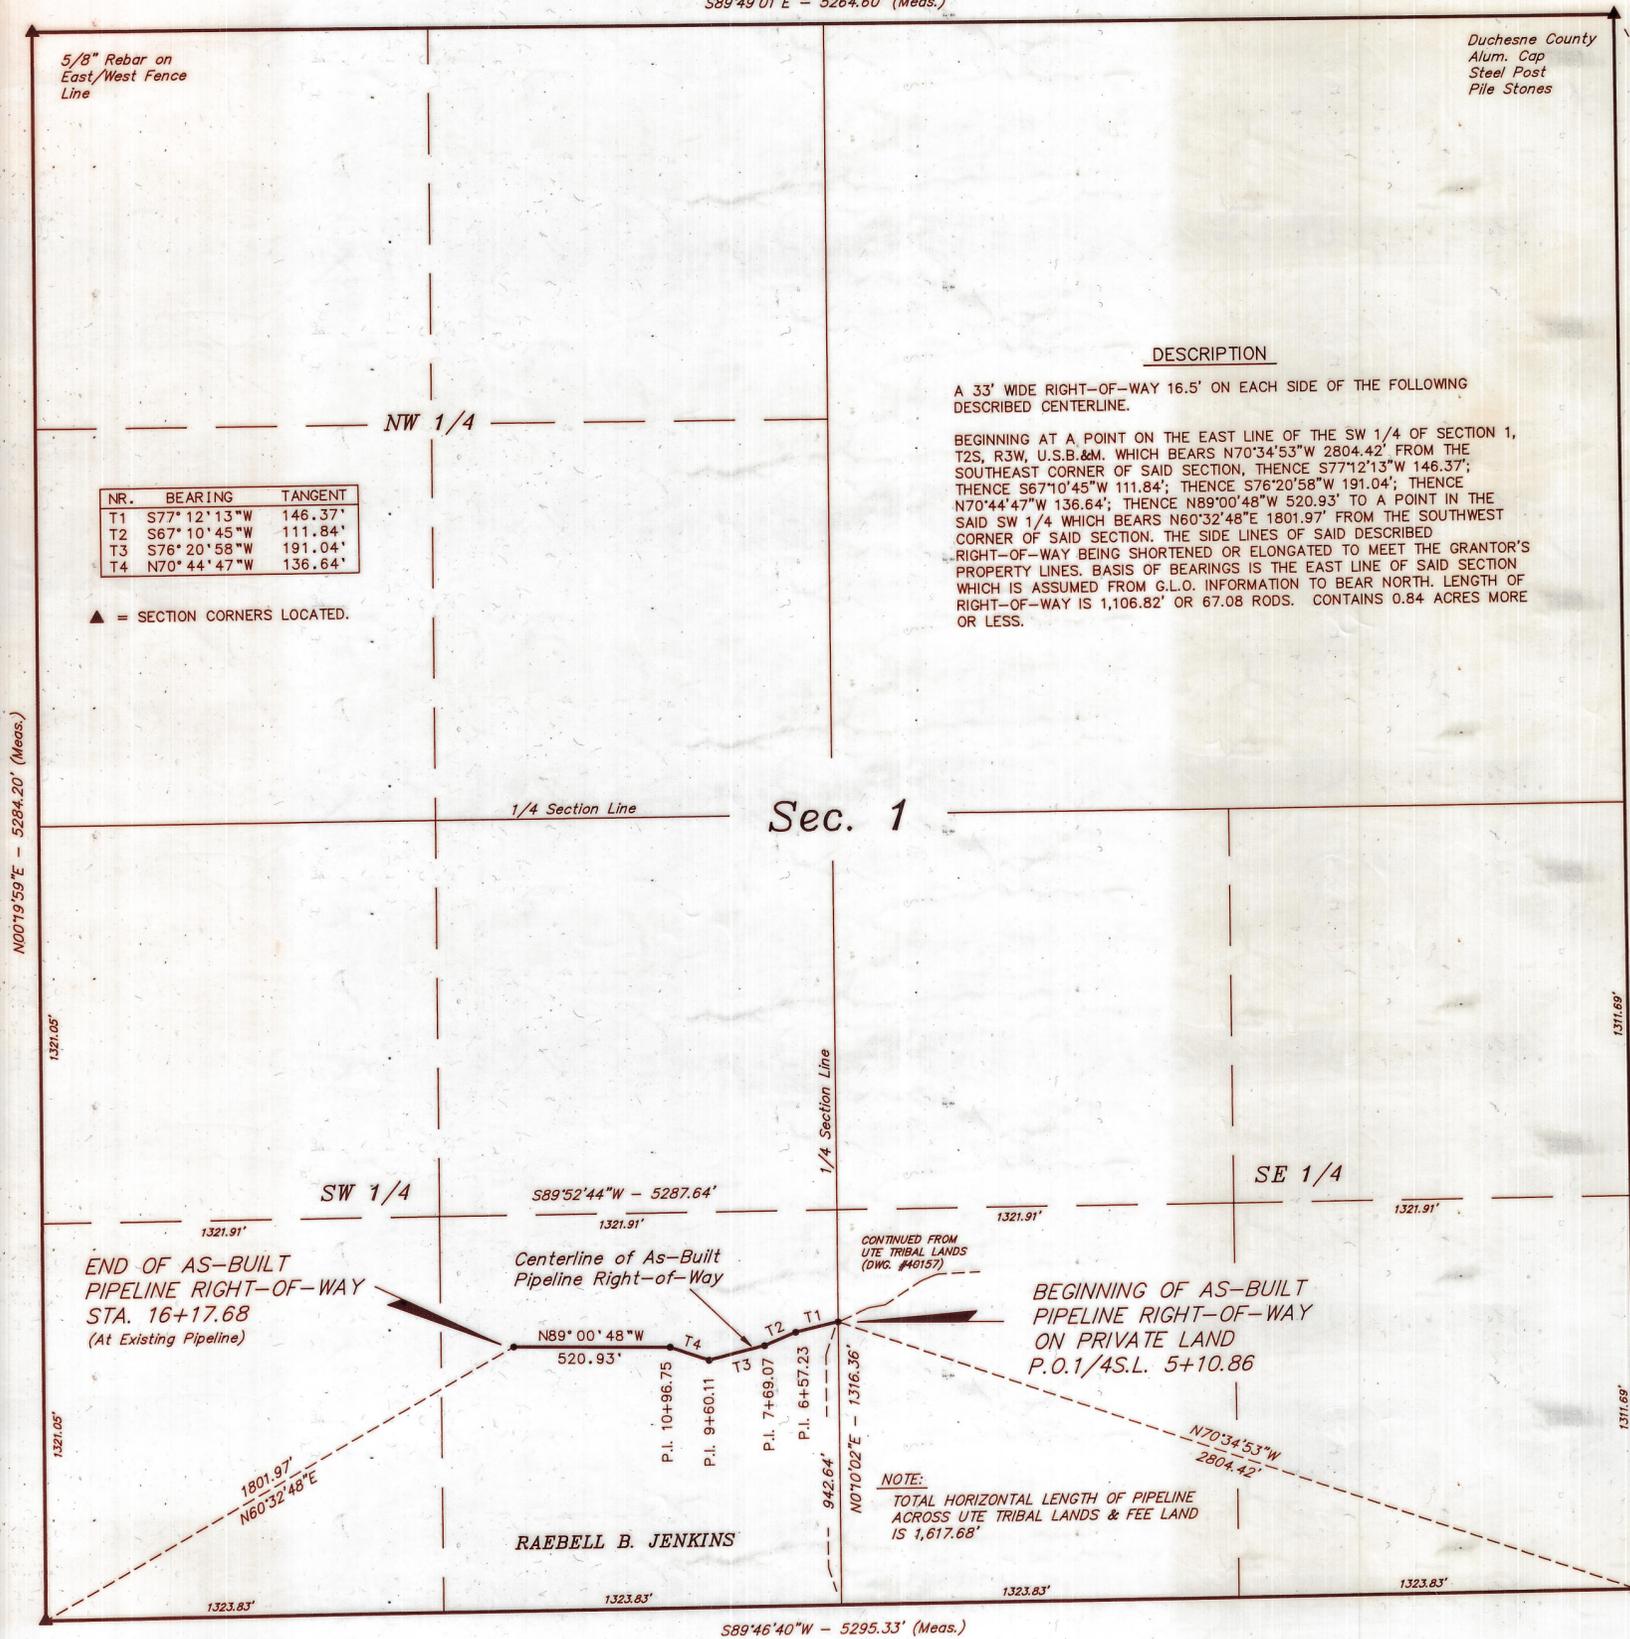

N00°19'59"E - 5284.20' (Meas.)

NORTH - G.L.C. (Basis of Bearings)
5246.76' - (Measured)

Sec. 1

RAEBELL B. JENKINS

Indian Pipe
Large Pile Stones

Spike