


**"AS-BUILT" SURVEY FOR
ELPASO E&P, CO.
KOFFORD 2-36B5
SECTION 36, TOWNSHIP 2 SOUTH, RANGE 5 WEST
UINTAH SPECIAL BASE AND MERIDIAN**




SCALE: 1=200'

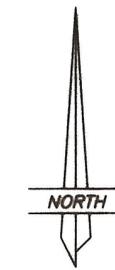

THIS SURVEY WAS PERFORMED USING GLOBAL POSITIONING SYSTEM PROCEDURES AND EQUIPMENT

THE BASIS OF BEARINGS IS GEODETIC NORTH DERIVED FROM G.P.S. OBSERVATIONS USING THE UTAH STATE G.P.S. VIRTUAL REFERENCE STATION CONTROL NETWORK MAINTAINED AND OPERATED BY THE AUTOMATED GEOGRAPHIC REFERENCE CENTER

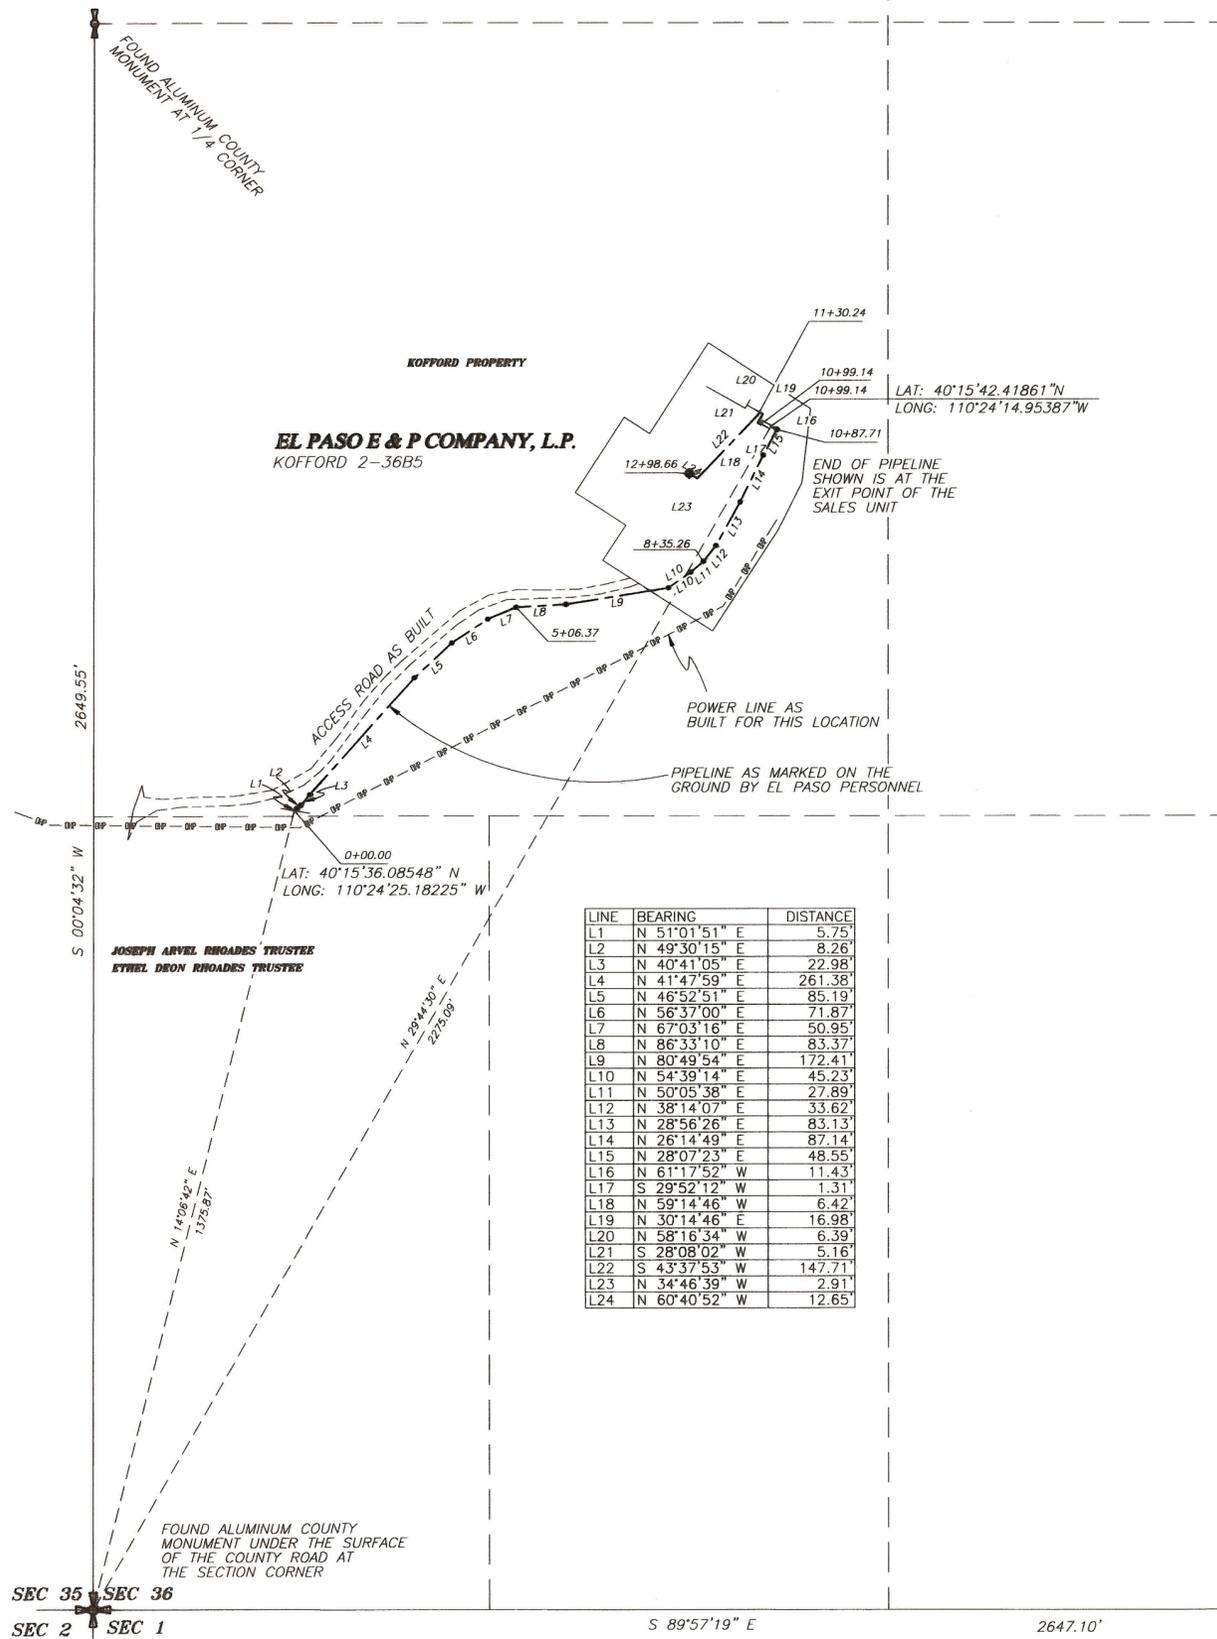

LINE	BEARING	DISTANCE
L1	N 51°01'51" E	5.75'
L2	N 49°30'15" E	8.26'
L3	N 40°41'05" E	22.98'
L4	N 41°47'59" E	261.38'
L5	N 46°52'51" E	85.19'
L6	N 56°37'00" E	71.87'
L7	N 67°03'16" E	50.95'
L8	N 86°33'10" E	83.37'
L9	N 80°49'54" E	172.41'
L10	N 54°39'14" E	45.23'
L11	N 50°05'38" E	27.89'
L12	N 38°14'07" E	33.62'
L13	N 28°56'26" E	83.13'
L14	N 26°14'49" E	87.14'
L15	N 28°07'23" E	48.55'
L16	N 61°17'52" W	11.43'
L17	S 29°52'12" W	1.31'
L18	N 59°14'46" W	6.42'
L19	N 30°14'46" E	16.98'
L20	N 58°16'34" W	6.39'
L21	S 28°08'02" W	5.16'
L22	S 43°37'53" W	147.71'
L23	N 34°46'39" W	2.91'
L24	N 60°40'52" W	12.65'


SURVEYOR'S CERTIFICATE

This is to certify that this plat was prepared from the field notes and electronic data collector files of an actual survey made by me, or under my personal supervision, of the parcel of land shown hereon, and that the monuments indicated were found or set during said survey, and that this plat accurately represents said survey to the best of my knowledge.



Jerry D. Allred, Professional Land Surveyor,
Certificate No. 148951, (Utah)

COUNTY SURVEYOR'S FILE # 2252

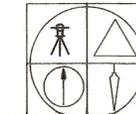

JERRY D. ALLRED AND ASSOCIATES
SURVEYING CONSULTANTS

1235 NORTH 700 EAST ST. -- P.O. BOX 975
DUCHESSNE, UTAH 84021
(435) 738-5352