

SEC 16 SEC 15
SEC 21 SEC 22

S 89°45'49" W 2652.35'


FOUND ALUMINUM COUNTY
MONUMENT AT SECTION CORNER

FOUND ALUMINUM COUNTY
MONUMENT AT 1/4 CORNER

AS-BUILT SURVEY FOR
EL PASO E&P COMPANY, L.P.

DWR 3-22C6

SECTION 22, TOWNSHIP 3 SOUTH, RANGE 6 WEST
UINTAH SPECIAL BASE AND MERIDIAN

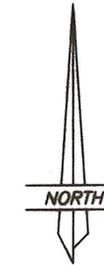


SCALE: 1=200'



THIS SURVEY WAS PERFORMED USING GLOBAL
POSITIONING SYSTEM PROCEDURES AND EQUIPMENT

THE BASIS OF BEARINGS IS GEODETIC NORTH DERIVED
FROM G.P.S. OBSERVATIONS USING THE UTAH STATE
G.P.S. VIRTUAL REFERENCE STATION CONTROL NETWORK
MAINTAINED AND OPERATED BY THE AUTOMATED
GEOGRAPHIC REFERENCE CENTER

LINE	BEARING	DISTANCE
L1	N 11°13'20" E	4.36
L2	N 08°46'06" E	10.64
L3	N 10°09'45" E	32.23
L4	N 04°13'47" E	5.64
L5	N 04°59'58" W	7.18
L6	N 22°05'08" W	20.90
L7	N 29°31'47" W	25.79
L8	N 28°47'23" W	97.84
L9	N 30°39'08" W	126.62
L10	N 37°54'08" W	102.45
L11	N 55°25'18" W	173.92
L12	N 55°26'24" W	180.26
L13	N 53°57'15" W	245.68
L14	N 55°11'37" W	175.35
L15	N 50°44'29" W	71.70
L16	N 34°30'09" W	98.42
L17	N 29°41'39" W	49.97
L18	N 23°24'38" W	60.89
L19	N 17°57'11" W	47.87
L20	N 09°12'50" W	40.01
L21	N 00°17'15" W	70.55
L22	N 03°58'49" E	183.07
L23	N 00°00'33" E	106.15
L24	N 14°13'28" W	32.22
L25	N 38°51'04" W	20.40
L26	N 52°11'52" W	33.20
L27	N 71°50'06" W	46.80
L28	S 83°26'59" W	39.25
L29	S 61°15'03" W	8.94

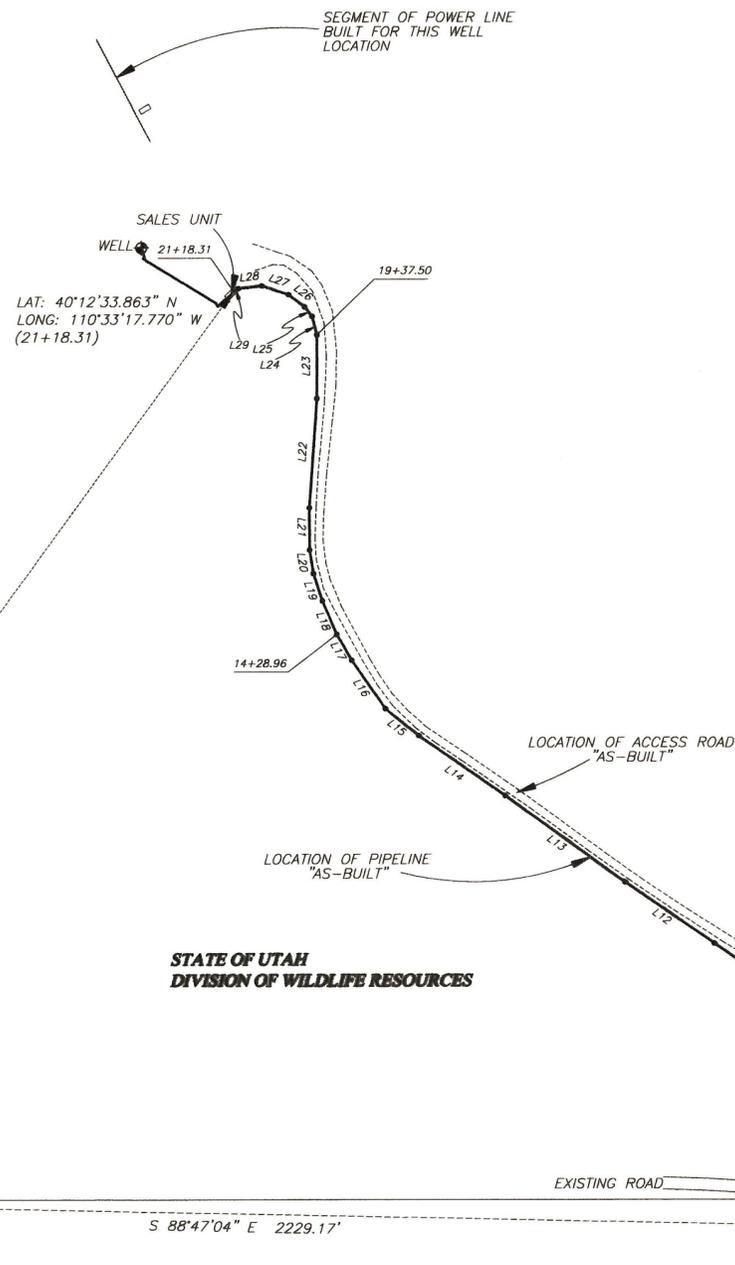


STATE OF UTAH
DIVISION OF WILDLIFE RESOURCES

STATE OF UTAH
DIVISION OF WILDLIFE RESOURCES


SURVEYOR'S CERTIFICATE

This is to certify that this plat was prepared from the field notes and electronic data collector files of an actual survey made by me, or under my personal supervision, of the location, pipeline and access road shown hereon, and that the monuments indicated were found or set during said survey, and that this plat accurately represents said survey to the best of my knowledge.

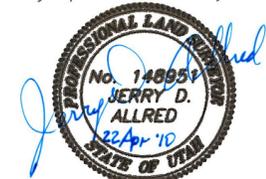

Jerry D. Allred, Professional Land Surveyor,
Certificate 148951 (Utah)

COUNTY SURVEYOR'S FILE # 2256

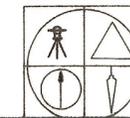

JERRY D. ALLRED AND ASSOCIATES
SURVEYING CONSULTANTS
1235 NORTH 700 EAST ST. -- P.O. BOX 975
DUCHESNE, UTAH 84021
(435) 738-5352

22 APR 2010 01-128-157

SEC 21 SEC 22
SEC 28 SEC 27

FOUND ALUMINUM COUNTY
MONUMENT AT SECTION CORNER

S 00°09'51" E 2636.47'

N 59°55'12" E
1074.88

S 88°47'04" E 2229.17'

PIPELINE TIE-IN
LAT: 40°12'18.393" N
LONG: 110°33'03.232" W
(0+00.00)