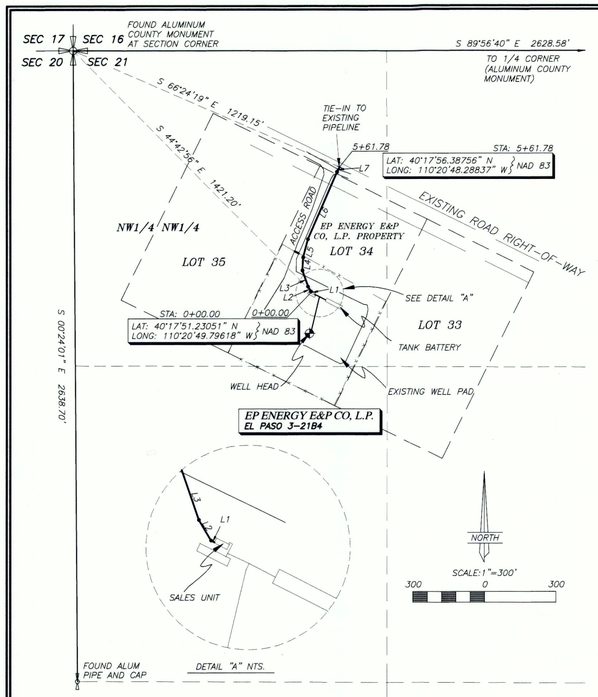

PIPELINE AS-BUILT SURVEY FOR

KINDER MORGAN ALTAMONT, LLC.

EL PASO 3-21B4

SECTION 21, T2S, R4W, U.S.B.&M.

DUCHESNE COUNTY, UTAH

LINE	BEARING	DISTANCE
L1	N 59°56'10" W	3.90'
L2	N 30°37'09" W	23.41'
L3	N 19°02'41" W	71.57'
L4	N 03°05'13" E	54.41'
L5	N 14°50'46" E	78.67'
L6	N 23°26'57" E	306.98'
L7	N 27°55'18" E	22.84'

THIS SURVEY WAS PERFORMED USING GLOBAL POSITIONING SYSTEM PROCEDURES AND EQUIPMENT

THE BASIS OF BEARINGS IS GEODETIC NORTH DERIVED FROM G.P.S. OBSERVATIONS AT A CONTROL POINT LOCATED AT LAT. 40°21'33.56882"N AND LONG. 110°16'31.53266"W USING THE UTAH STATE G.P.S. VIRTUAL REFERENCE STATION CONTROL NETWORK MAINTAINED AND OPERATED BY THE AUTOMATED GEOGRAPHIC REFERENCE CENTER

SURVEYOR'S CERTIFICATE

This is to certify that this plat was prepared from the field notes and electronic data collector files of an actual survey made by me, or under my personal supervision, of the pipeline shown hereon, and that this plat accurately represents said survey to the best of my knowledge.

PROFESSIONAL LAND SURVEYOR No. 148951 JERRY D. ALLRED 2 JAN 2014 STATE OF UTAH

JERRY D. ALLRED, REGISTERED LAND SURVEYOR, CERTIFICATE NO. 148951 (UTAH)

JERRY D. ALLRED AND ASSOCIATES
SURVEYING CONSULTANTS
1235 NORTH 700 EAST--P.O. BOX 975
DUCHESNE, UTAH 84021
(435) 738-5352

2 JAN 2014 12-121-089

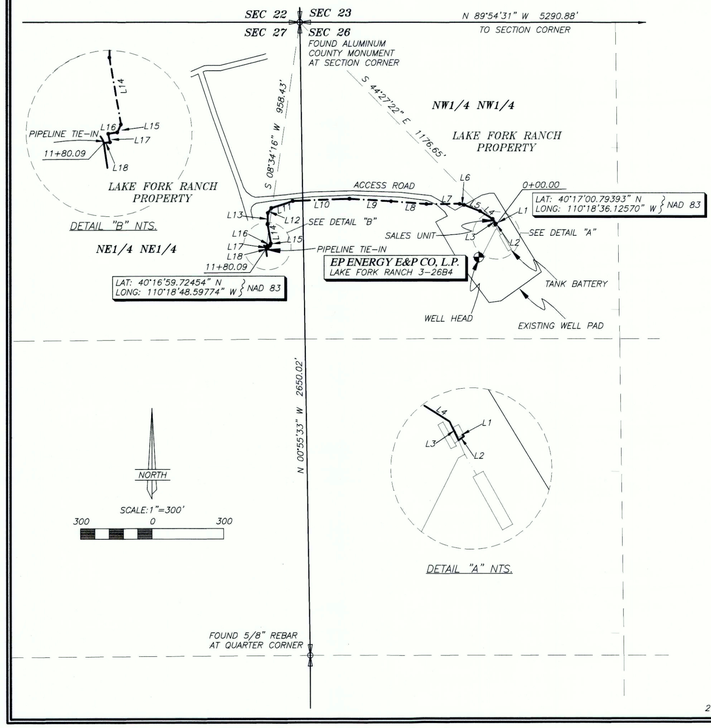

PIPELINE "AS-BUILT" SURVEY FOR

KINDER MORGAN ALTAMONT, LLC.

LAKE FORK RANCH 3-26B4

SECTION 26, T2S, R4W, U.S.B.&M.

DUCHESNE COUNTY, UTAH

LINE	BEARING	DISTANCE
L1	S 42°19'12" E	3.08'
L2	S 54°02'59" W	8.42'
L3	N 26°32'38" W	25.92'
L4	N 58°11'23" W	62.87'
L5	N 68°55'05" W	71.23'
L6	N 75°33'49" W	19.13'
L7	S 89°43'05" W	139.77'
L8	N 85°24'01" W	147.93'
L9	N 86°33'57" W	174.60'
L10	S 87°49'52" W	238.22'
L11	S 72°09'51" W	94.53'
L12	S 35°32'40" W	25.50'
L13	S 01°38'06" W	47.52'
L14	S 09°50'38" E	81.61'
L15	S 24°56'05" W	10.48'
L16	S 80°39'07" W	11.14'
L17	S 12°17'20" E	10.44'
L18	S 82°18'46" W	7.70'

THIS SURVEY WAS PERFORMED USING GLOBAL POSITIONING SYSTEM PROCEDURES AND EQUIPMENT

THE BASIS OF BEARINGS IS GEODETIC NORTH DERIVED FROM G.P.S. OBSERVATIONS AT A CONTROL POINT LOCATED AT LAT. 40°21'33.56882"N AND LONG. 110°16'31.53266"W USING THE UTAH STATE G.P.S. VIRTUAL REFERENCE STATION CONTROL NETWORK MAINTAINED AND OPERATED BY THE AUTOMATED GEOGRAPHIC REFERENCE CENTER

SURVEYOR'S CERTIFICATE

This is to certify that this plat was prepared from the field notes and electronic data collector files of an actual survey made by me, or under my personal supervision, of the pipeline shown hereon, and that this plat accurately represents said survey to the best of my knowledge.

PROFESSIONAL LAND SURVEYOR No. 148951 JERRY D. ALLRED 24 DEC '13 STATE OF UTAH

JERRY D. ALLRED, REGISTERED LAND SURVEYOR, CERTIFICATE NO. 148951 (UTAH)

JERRY D. ALLRED & ASSOCIATES
SURVEYING CONSULTANTS
1235 NORTH 700 EAST--P.O. BOX 975
DUCHESNE, UTAH 84021
(435) 738-5352

24 DEC 2013 12-121-099

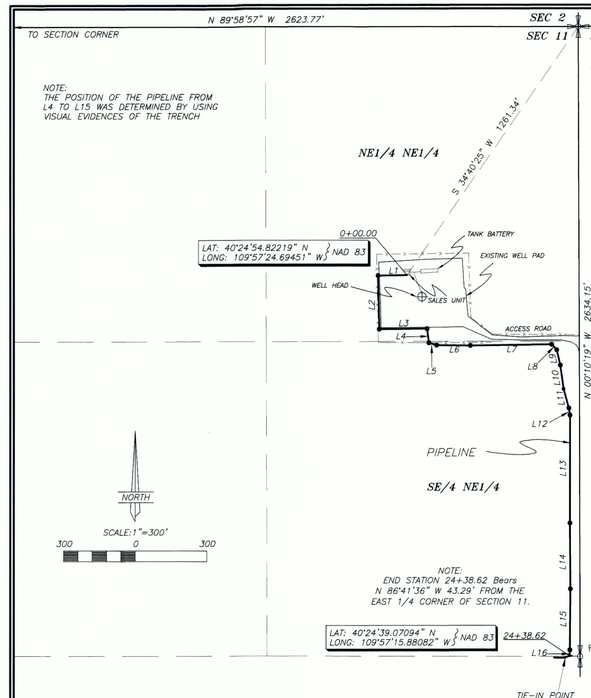

PIPELINE "AS-BUILT" SURVEY FOR

KINDER MORGAN ALTAMONT, LLC.

BISEL GURR 2-11A1

SECTION 11, T1S, R1W, U.S.B.&M.

UINTAH COUNTY, UTAH

LINE	BEARING	DISTANCE
L1	S 88°46'25" W	121.02'
L2	S 01°12'08" E	223.25'
L3	N 89°40'58" E	200.63'
L4	S 06°52'25" E	59.35'
L5	S 72°48'37" E	33.85'
L6	S 89°33'27" E	142.15'
L7	N 89°16'44" E	339.57'
L8	S 43°35'09" E	31.43'
L9	S 13°26'10" E	65.79'
L10	S 07°29'01" E	100.27'
L11	S 15°46'12" E	83.27'
L12	S 09°51'08" E	30.45'
L13	S 00°08'25" W	451.13'
L14	S 00°30'37" E	275.47'
L15	S 00°34'41" W	256.30'
L16	N 00°27'42" E	24.69'

THIS SURVEY WAS PERFORMED USING GLOBAL POSITIONING SYSTEM PROCEDURES AND EQUIPMENT

THE BASIS OF BEARINGS IS GEODETIC NORTH DERIVED FROM G.P.S. OBSERVATIONS USING THE UTAH STATE G.P.S. VIRTUAL REFERENCE STATION CONTROL NETWORK MAINTAINED AND OPERATED BY THE AUTOMATED GEOGRAPHIC REFERENCE CENTER

SURVEYOR'S CERTIFICATE

This is to certify that this plat was prepared from the field notes and electronic data collector files of an actual survey made by me, or under my personal supervision, of the pipeline shown hereon, and that this plat accurately represents said survey to the best of my knowledge.

PROFESSIONAL LAND SURVEYOR No. 148951 JERRY D. ALLRED 20 DEC '13 STATE OF UTAH

JERRY D. ALLRED, REGISTERED LAND SURVEYOR, CERTIFICATE NO. 148951 (UTAH)

JERRY D. ALLRED AND ASSOCIATES
SURVEYING CONSULTANTS
1235 NORTH 700 EAST--P.O. BOX 975
DUCHESNE, UTAH 84021
(435) 738-5352

20 DEC 2013 12-121-097

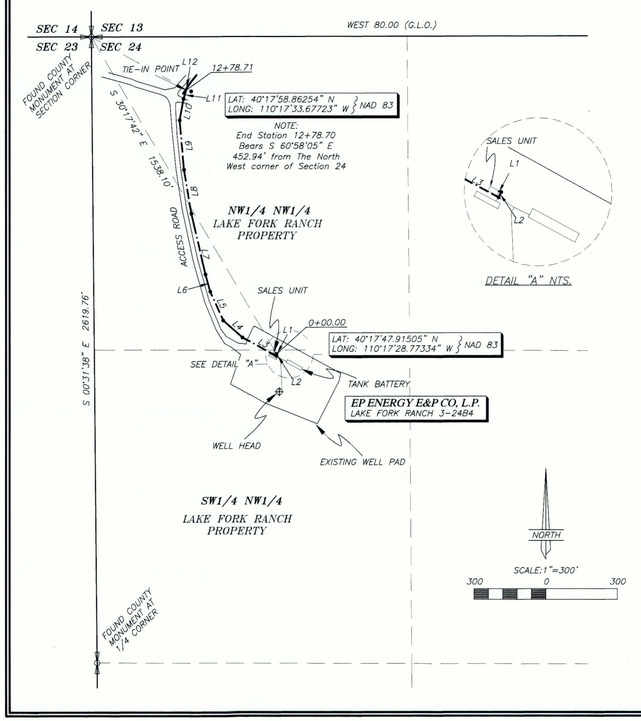

PIPELINE "AS-BUILT" SURVEY FOR

KINDER MORGAN ALTAMONT, LLC.

LAKE FORK RANCH 3-24B4

SECTION 24, T2S, R4W, U.S.B.&M.

DUCHESNE COUNTY, UTAH

LINE	BEARING	DISTANCE
L1	S 75°28'14" E	3.64'
L2	S 25°41'05" W	8.12'
L3	N 61°32'29" W	162.03'
L4	N 48°27'10" W	108.26'
L5	N 24°11'48" W	132.13'
L6	N 15°31'43" W	74.69'
L7	N 13°05'24" W	262.02'
L8	N 09°31'14" W	186.42'
L9	N 04°55'30" W	207.99'
L10	N 10°16'02" E	89.98'
L11	N 16°50'08" E	41.13'
L12	N 69°57'34" W	2.30'

THIS SURVEY WAS PERFORMED USING GLOBAL POSITIONING SYSTEM PROCEDURES AND EQUIPMENT

THE BASIS OF BEARINGS IS GEODETIC NORTH DERIVED FROM G.P.S. OBSERVATIONS AT A CONTROL POINT LOCATED AT LAT. 40°21'33.56882"N AND LONG. 110°16'31.53266"W USING THE UTAH STATE G.P.S. VIRTUAL REFERENCE STATION CONTROL NETWORK MAINTAINED AND OPERATED BY THE AUTOMATED GEOGRAPHIC REFERENCE CENTER

SURVEYOR'S CERTIFICATE

This is to certify that this plat was prepared from the field notes and electronic data collector files of an actual survey made by me, or under my personal supervision, of the pipeline shown hereon, and that this plat accurately represents said survey to the best of my knowledge.

PROFESSIONAL LAND SURVEYOR No. 148951 JERRY D. ALLRED 24 DEC '13 STATE OF UTAH

JERRY D. ALLRED, REGISTERED LAND SURVEYOR, CERTIFICATE NO. 148951 (UTAH)

JERRY D. ALLRED AND ASSOCIATES
SURVEYING CONSULTANTS
1235 NORTH 700 EAST--P.O. BOX 975
DUCHESNE, UTAH 84021
(435) 738-5352

24 DEC 2013 12-121-100

County Surveyors File # 2931