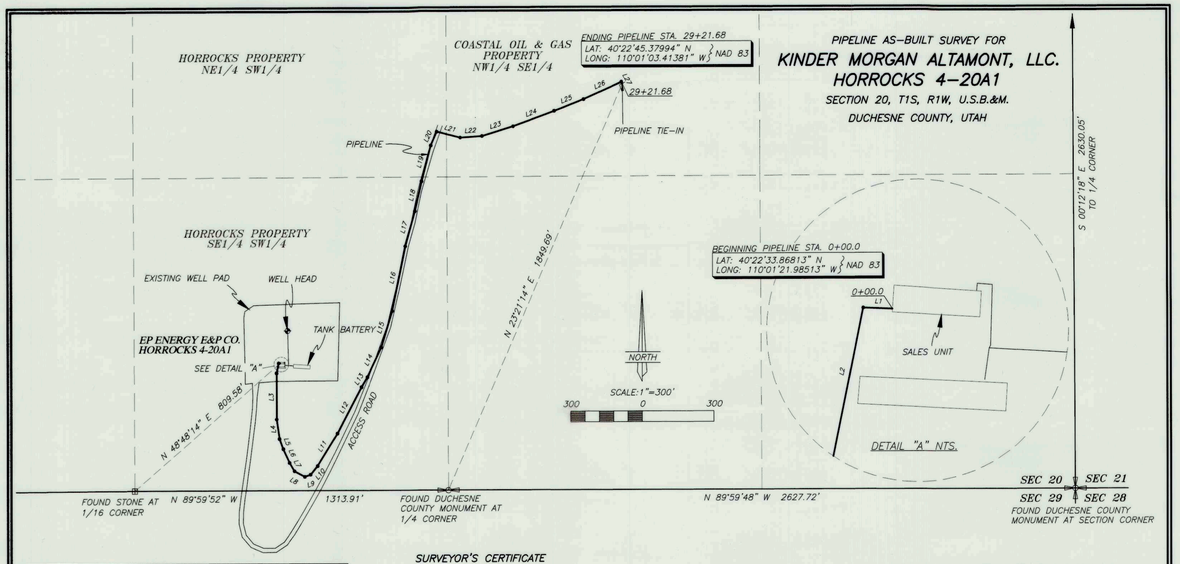

LINE	BEARING	DISTANCE	LINE	BEARING	DISTANCE
L1	N 87°40'39" W	5.97'	L15	N 16°51'13" E	158.93'
L2	S 11°27'21" W	42.64'	L16	N 11°39'11" E	276.19'
L3	S 00°03'56" E	193.22'	L17	N 15°24'34" E	151.85'
L4	S 08°06'06" E	82.64'	L18	N 12°55'02" E	127.87'
L5	S 20°39'32" E	44.81'	L19	N 14°24'49" E	155.23'
L6	S 24°21'11" E	64.00'	L20	N 22°54'41" E	63.39'
L7	S 30°39'25" E	40.47'	L21	S 75°27'50" E	102.24'
L8	S 61°18'09" E	48.95'	L22	N 86°04'00" E	91.23'
L9	N 70°19'15" E	25.66'	L23	N 72°47'49" E	136.88'
L10	N 39°29'15" E	47.15'	L24	N 69°52'28" E	184.16'
L11	N 31°28'10" E	159.24'	L25	N 68°30'16" E	132.18'
L12	N 27°29'49" E	218.64'	L26	N 65°36'31" E	173.65'
L13	N 30°54'35" E	48.37'	L27	S 29°27'27" E	8.70'
L14	N 25°11'38" E	137.42'			

SURVEYOR'S CERTIFICATE

This is to certify that this plat was prepared from the field notes and electronic data collector files of an actual survey made by me, or under my personal supervision, of the pipeline shown hereon, and that this plat accurately represents said survey to the best of my knowledge.

PROFESSIONAL LAND SURVEYOR No. 148951 JERRY D. ALLRED 24 FEB '14 STATE OF UTAH

JERRY D. ALLRED, REGISTERED LAND SURVEYOR, CERTIFICATE NO. 148951 (UTAH)

24 FEB 2014

THIS SURVEY WAS PERFORMED USING GLOBAL POSITIONING SYSTEM PROCEDURES AND EQUIPMENT

THE BASIS OF BEARINGS IS GEODETIC NORTH DERIVED FROM G.P.S. OBSERVATIONS AT A SECTION CORNER LOCATED AT LAT. 40°20'35.62573"N AND LONG. 109°59'30.14134"W USING THE UTAH STATE G.P.S. VIRTUAL REFERENCE STATION CONTROL NETWORK MAINTAINED AND OPERATED BY THE AUTOMATED GEOGRAPHIC REFERENCE CENTER

COUNTY SURVEYOR'S FILE NUMBER

JERRY D. ALLRED AND ASSOCIATES
SURVEYING CONSULTANTS
1235 NORTH 700 EAST---P.O. BOX 975
DUCHESNE, UTAH 84021
(435) 738-5352

12-121-149

PIPELINE AS-BUILT SURVEY FOR

KINDER MORGAN ALTAMONT, LLC.

HORROCKS 4-20A1

SECTION 20, T1S, R1W, U.S.B.&M.

DUCHESNE COUNTY, UTAH

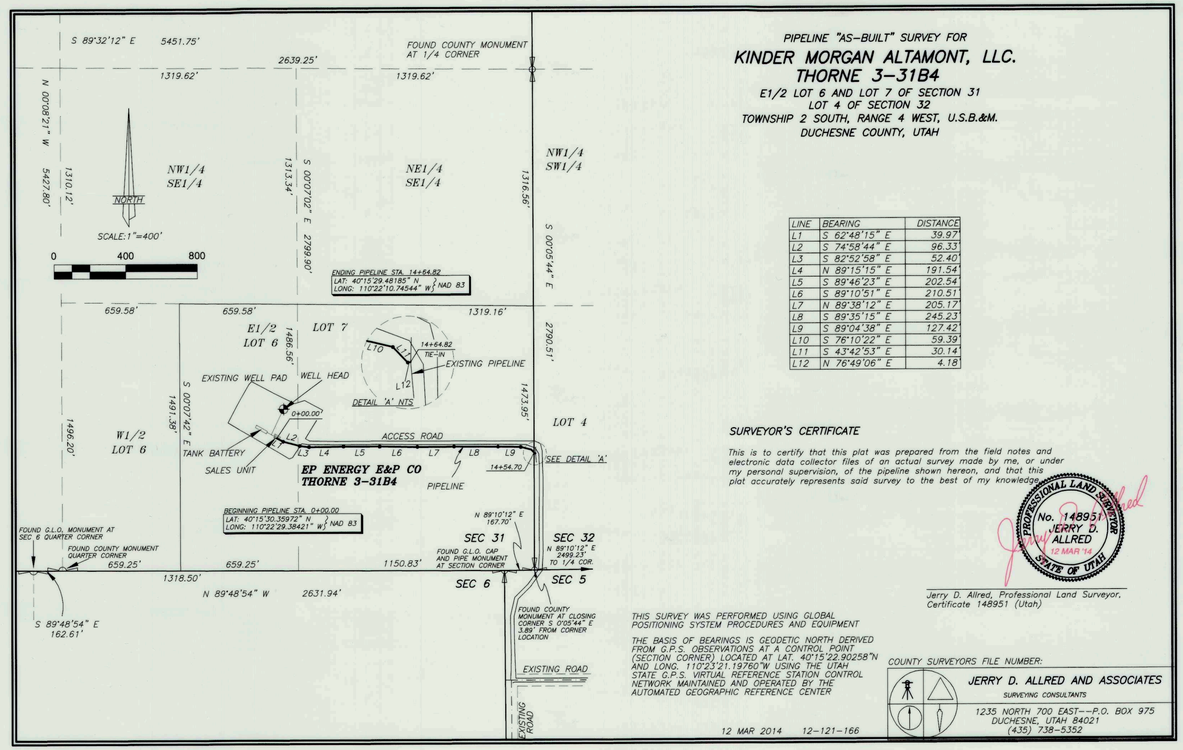

PIPELINE "AS-BUILT" SURVEY FOR

KINDER MORGAN ALTAMONT, LLC.

THORNE 3-31B4

E1/2 LOT 6 AND LOT 7 OF SECTION 31
LOT 4 OF SECTION 32
TOWNSHIP 2 SOUTH, RANGE 4 WEST, U.S.B.&M.
DUCHESNE COUNTY, UTAH

LINE	BEARING	DISTANCE
L1	S 62°48'15" E	39.97'
L2	S 74°58'44" E	96.33'
L3	S 82°52'58" E	52.40'
L4	N 89°15'15" E	191.54'
L5	S 89°46'23" E	202.54'
L6	S 89°10'51" E	210.51'
L7	N 89°38'12" E	205.17'
L8	S 89°35'15" E	245.23'
L9	S 89°04'38" E	127.42'
L10	S 76°10'22" E	59.39'
L11	S 43°42'53" E	30.14'
L12	N 76°49'06" E	4.18'

SURVEYOR'S CERTIFICATE

This is to certify that this plat was prepared from the field notes and electronic data collector files of an actual survey made by me, or under my personal supervision, of the pipeline shown hereon, and that this plat accurately represents said survey to the best of my knowledge.

PROFESSIONAL LAND SURVEYOR No. 148951 JERRY D. ALLRED 12 MAR '14 STATE OF UTAH

Jerry D. Allred, Professional Land Surveyor, Certificate 148951 (Utah)

THIS SURVEY WAS PERFORMED USING GLOBAL POSITIONING SYSTEM PROCEDURES AND EQUIPMENT

THE BASIS OF BEARINGS IS GEODETIC NORTH DERIVED FROM G.P.S. OBSERVATIONS AT A CONTROL POINT (SECTION CORNER) LOCATED AT LAT. 40°15'22.90258"N AND LONG. 110°23'21.19760"W USING THE UTAH STATE G.P.S. VIRTUAL REFERENCE STATION CONTROL NETWORK MAINTAINED AND OPERATED BY THE AUTOMATED GEOGRAPHIC REFERENCE CENTER

COUNTY SURVEYORS FILE NUMBER:

JERRY D. ALLRED AND ASSOCIATES
SURVEYING CONSULTANTS
1235 NORTH 700 EAST---P.O. BOX 975
DUCHESNE, UTAH 84021
(435) 738-5352

12 MAR 2014 12-121-166

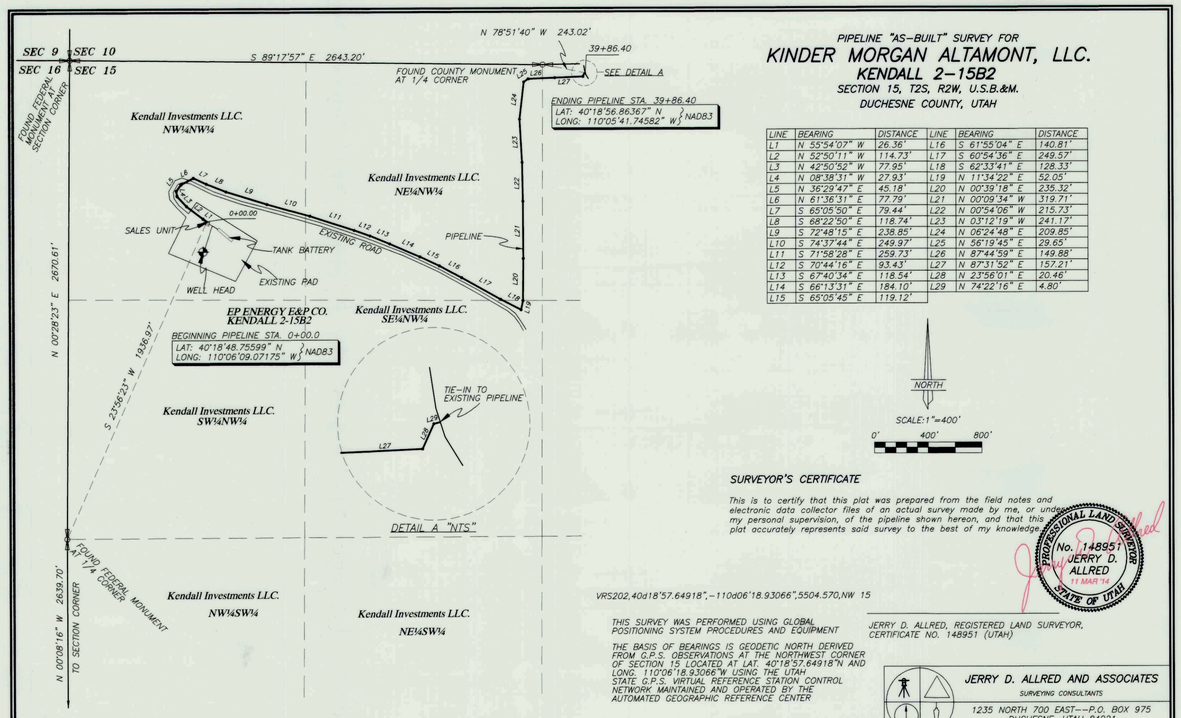

LINE	BEARING	DISTANCE	LINE	BEARING	DISTANCE
L1	N 55°54'07" W	26.36'	L16	S 61°55'04" E	140.81'
L2	N 52°50'11" W	114.73'	L17	S 60°54'36" E	249.57'
L3	N 42°50'52" W	77.95'	L18	S 62°33'41" E	128.33'
L4	N 08°38'31" W	27.93'	L19	N 11°34'22" E	52.05'
L5	N 36°29'47" E	45.18'	L20	N 00°39'18" E	235.32'
L6	N 61°36'31" E	77.79'	L21	N 00°09'34" W	319.71'
L7	S 65°05'50" E	79.44'	L22	N 00°54'06" W	215.73'
L8	S 68°22'50" E	118.74'	L23	N 03°12'19" W	241.17'
L9	S 72°48'15" E	238.85'	L24	N 06°24'48" E	209.85'
L10	S 74°37'44" E	249.97'	L25	N 56°19'45" E	29.65'
L11	S 71°58'28" E	259.73'	L26	N 87°44'59" E	149.88'
L12	S 70°44'16" E	93.43'	L27	N 87°31'52" E	157.21'
L13	S 67°40'34" E	118.54'	L28	N 23°56'01" E	20.46'
L14	S 66°13'31" E	184.10'	L29	N 74°22'16" E	4.80'
L15	S 65°05'45" E	119.12'			

SURVEYOR'S CERTIFICATE

This is to certify that this plat was prepared from the field notes and electronic data collector files of an actual survey made by me, or under my personal supervision, of the pipeline shown hereon, and that this plat accurately represents said survey to the best of my knowledge.

PROFESSIONAL LAND SURVEYOR No. 148951 JERRY D. ALLRED 11 MAR '14 STATE OF UTAH

VRS202,40d18'57.64918",-110d06'18.93066",5504.570,NW 15

JERRY D. ALLRED, REGISTERED LAND SURVEYOR, CERTIFICATE NO. 148951 (UTAH)

THIS SURVEY WAS PERFORMED USING GLOBAL POSITIONING SYSTEM PROCEDURES AND EQUIPMENT

THE BASIS OF BEARINGS IS GEODETIC NORTH DERIVED FROM G.P.S. OBSERVATIONS AT THE NORTHWEST CORNER OF SECTION 15 LOCATED AT LAT. 40°18'57.64918"N AND LONG. 110°06'18.93066"W USING THE UTAH STATE G.P.S. VIRTUAL REFERENCE STATION CONTROL NETWORK MAINTAINED AND OPERATED BY THE AUTOMATED GEOGRAPHIC REFERENCE CENTER

JERRY D. ALLRED AND ASSOCIATES
SURVEYING CONSULTANTS
1235 NORTH 700 EAST---P.O. BOX 975
DUCHESNE, UTAH 84021
(435) 738-5352

11 MAR 2014 12-121-167

PIPELINE "AS-BUILT" SURVEY FOR

KINDER MORGAN ALTAMONT, LLC.

KENDALL 2-15B2

SECTION 15, T2S, R2W, U.S.B.&M.

DUCHESNE COUNTY, UTAH

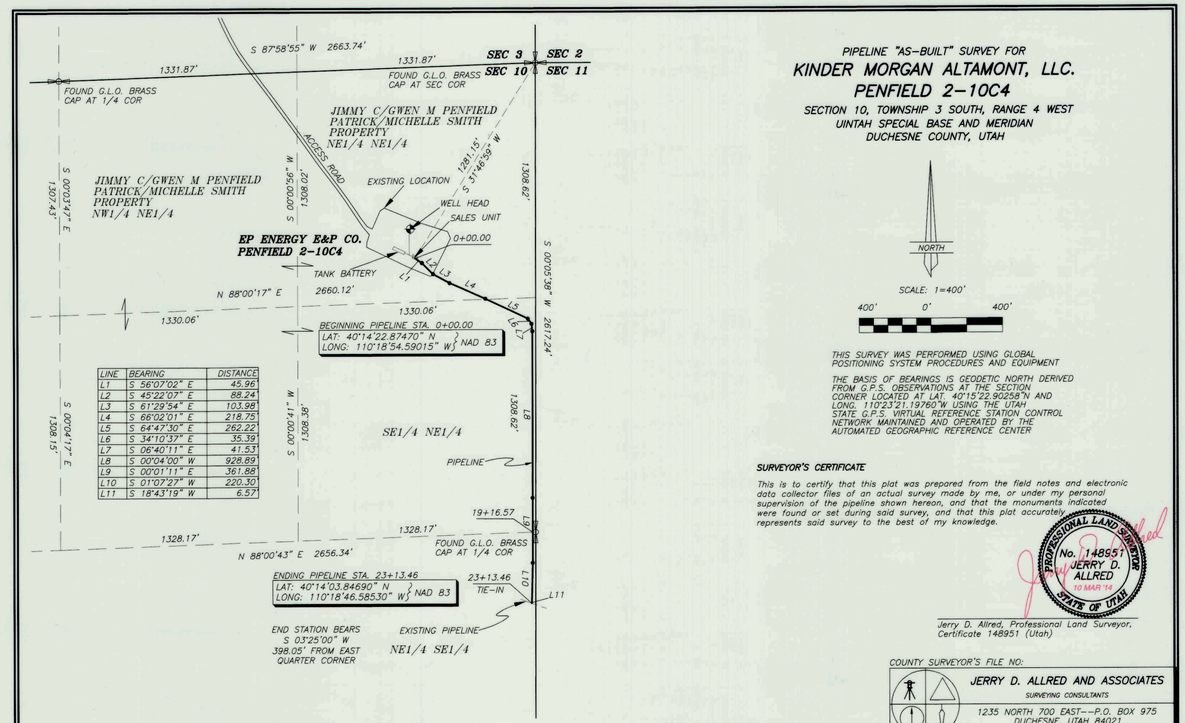

LINE	BEARING	DISTANCE
L1	S 56°07'02" E	45.96'
L2	S 45°22'07" E	88.24'
L3	S 61°29'54" E	103.98'
L4	S 66°02'01" E	218.75'
L5	S 64°47'30" E	262.22'
L6	S 34°10'37" E	35.39'
L7	S 06°40'11" E	41.53'
L8	S 00°04'00" W	928.89'
L9	S 00°01'11" E	361.88'
L10	S 01°07'27" W	220.30'
L11	S 18°43'19" W	6.57'

PIPELINE "AS-BUILT" SURVEY FOR

KINDER MORGAN ALTAMONT, LLC.

PENFIELD 2-10C4

SECTION 10, TOWNSHIP 3 SOUTH, RANGE 4 WEST
UINTAH SPECIAL BASE AND MERIDIAN
DUCHESNE COUNTY, UTAH

THIS SURVEY WAS PERFORMED USING GLOBAL POSITIONING SYSTEM PROCEDURES AND EQUIPMENT

THE BASIS OF BEARINGS IS GEODETIC NORTH DERIVED FROM G.P.S. OBSERVATIONS AT THE SECTION CORNER LOCATED AT LAT. 40°15'22.90258"N AND LONG. 110°23'21.19760"W USING THE UTAH STATE G.P.S. VIRTUAL REFERENCE STATION CONTROL NETWORK MAINTAINED AND OPERATED BY THE AUTOMATED GEOGRAPHIC REFERENCE CENTER

SURVEYOR'S CERTIFICATE

This is to certify that this plat was prepared from the field notes and electronic data collector files of an actual survey made by me, or under my personal supervision of the pipeline shown hereon, and that the monuments indicated were found or set during said survey, and that this plat accurately represents said survey to the best of my knowledge.

PROFESSIONAL LAND SURVEYOR No. 148951 JERRY D. ALLRED 10 MAR '14 STATE OF UTAH

Jerry D. Allred, Professional Land Surveyor, Certificate 148951 (Utah)

COUNTY SURVEYOR'S FILE NO:

JERRY D. ALLRED AND ASSOCIATES
SURVEYING CONSULTANTS
1235 NORTH 700 EAST---P.O. BOX 975
DUCHESNE, UTAH 84021
(435) 738-5352

10 MAR 2014 12-121-162

County Surveyors File # 2948