PIPELINE AS-BUILT SURVEY FOR

KINDER MORGAN ALTAMONT, LLC.

DUNCAN 2-34A1

SECTIONS 32, 33 & 34, T1S, R1W, U.S.B.&M.

DUCHESNE & UINTAH COUNTY, UTAH

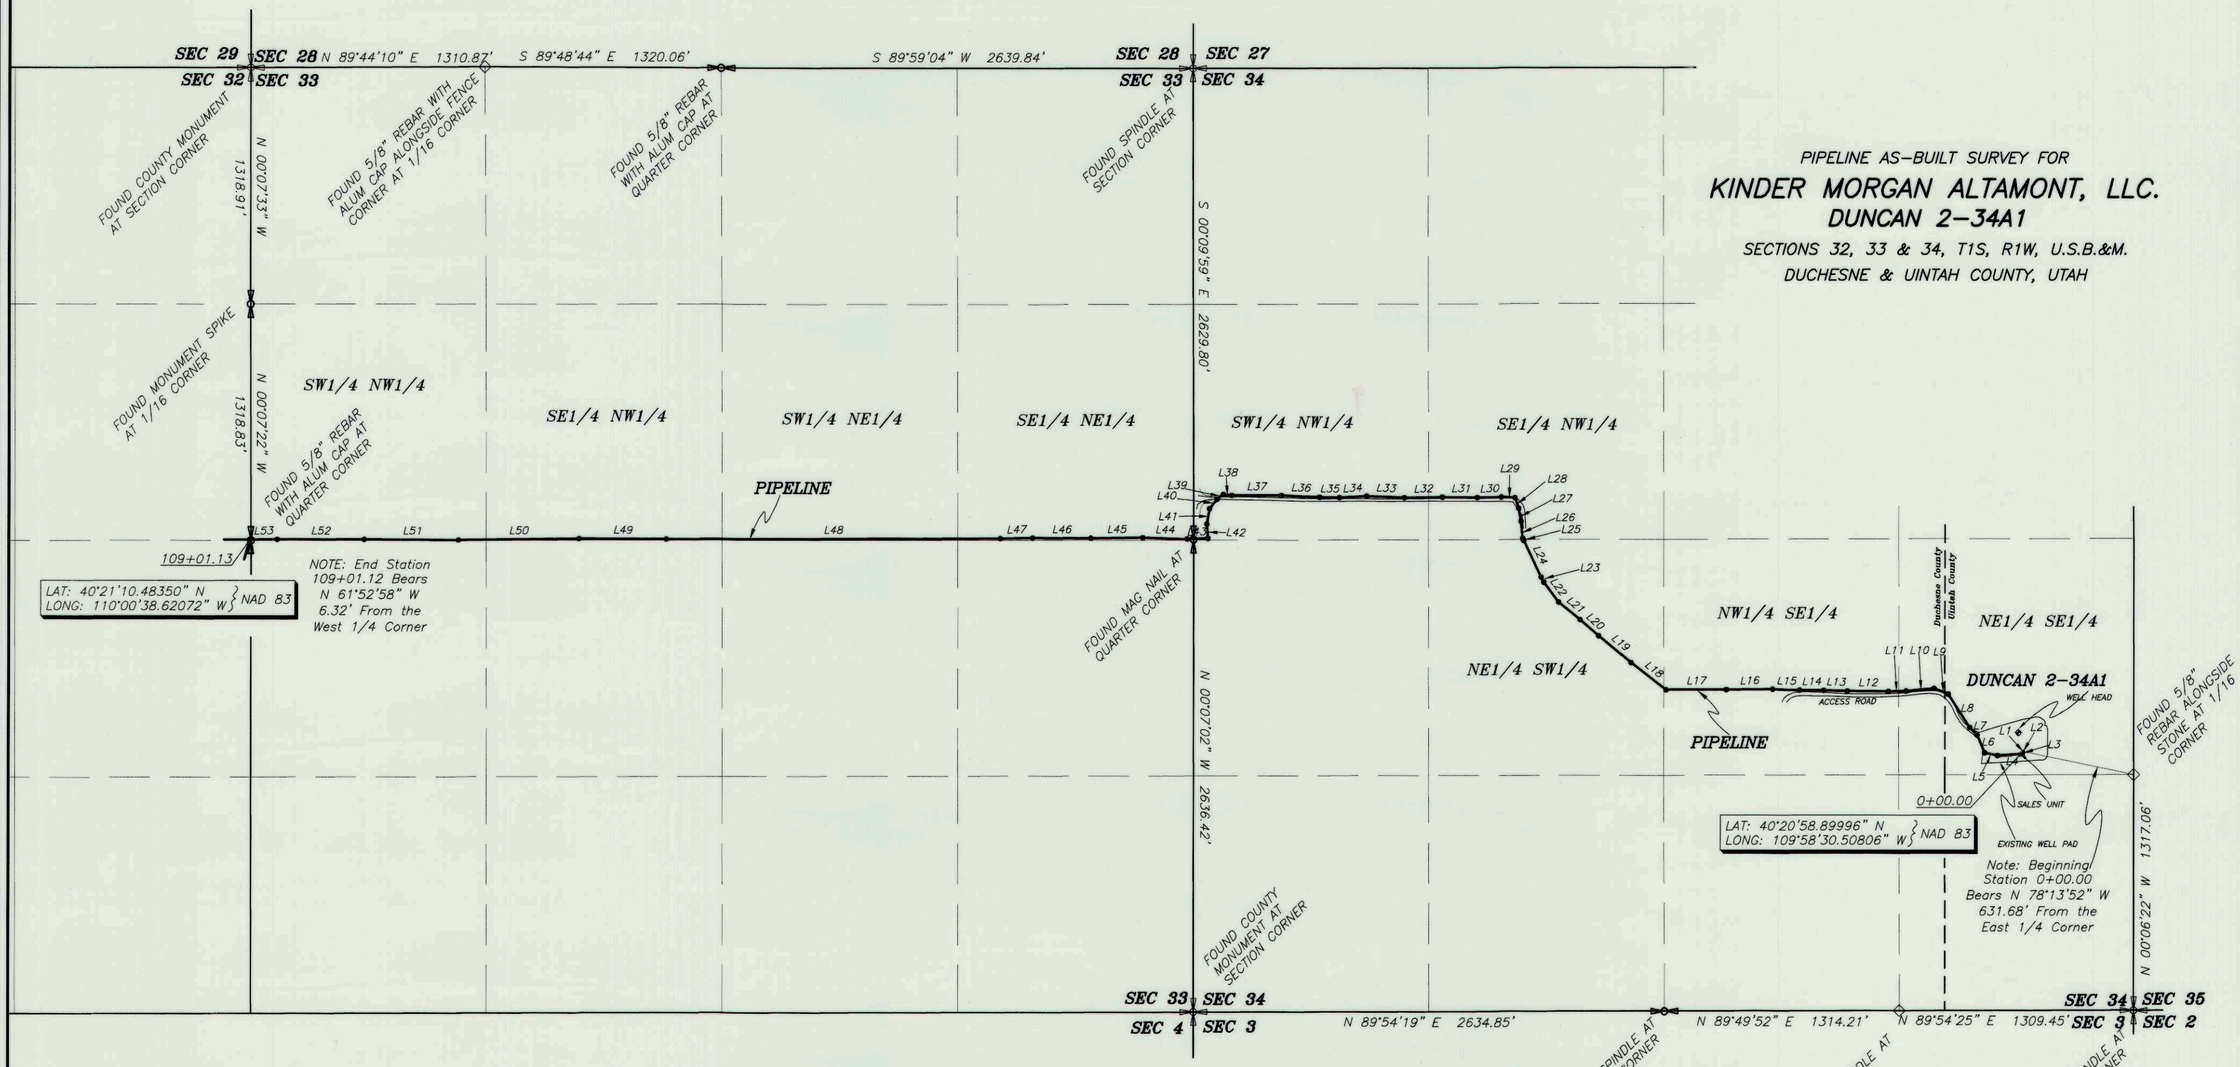

LINE	BEARING	DISTANCE
L1	N 01°38'23" W	1.20'
L2	S 87°59'29" E	2.34'
L3	S 08°15'25" E	13.10'
L4	S 85°25'47" W	147.96'
L5	N 77°47'36" W	74.12'
L6	N 23°09'05" W	107.05'
L7	N 44°45'59" W	58.13'
L8	N 32°55'17" W	222.52'
L9	N 68°21'05" W	84.84'
L10	S 84°59'16" W	157.57'
L11	S 88°04'43" W	99.13'
L12	N 89°32'02" W	228.86'
L13	N 88°01'54" W	132.57'
L14	N 89°49'15" W	134.41'
L15	N 87°47'57" W	152.90'
L16	S 89°21'21" W	258.39'
L17	S 89°57'45" W	337.69'
L18	N 52°23'56" W	246.82'
L19	N 50°28'56" W	235.01'
L20	N 48°57'39" W	138.47'
L21	N 50°59'14" W	155.03'
L22	N 36°32'24" W	138.93'
L23	N 28°27'40" W	32.40'
L24	N 25°31'37" W	226.63'
L25	N 24°56'15" W	11.53'
L26	N 05°54'34" W	96.05'
L27	N 09°56'55" W	72.61'

LINE	BEARING	DISTANCE
L28	N 18°58'35" W	62.91'
L29	N 86°02'40" W	76.11'
L30	S 88°59'41" W	135.38'
L31	N 89°10'41" W	196.13'
L32	S 89°10'45" W	213.10'
L33	N 87°33'11" W	210.35'
L34	S 86°26'21" W	151.82'
L35	N 89°00'47" W	112.87'
L36	N 87°20'11" W	212.10'
L37	N 89°48'08" W	278.38'
L38	N 84°20'23" W	47.99'
L39	S 51°57'00" W	43.91'
L40	S 38°30'09" W	67.44'
L41	S 09°30'53" W	86.91'
L42	S 04°23'44" E	80.25'
L43	S 88°39'30" W	116.94'
L44	N 88°27'51" W	248.55'
L45	S 89°24'03" W	290.10'
L46	N 89°44'41" W	325.99'
L47	S 88°53'44" W	179.57'
L48	S 89°49'08" W	1868.43'
L49	N 89°48'40" W	487.95'
L50	S 89°19'25" W	674.37'
L51	N 89°45'13" W	527.22'
L52	S 89°56'02" W	486.72'
L53	S 89°09'15" W	153.38'

NORTH

SCALE: 1"=600'

600 0 600

THIS SURVEY WAS PERFORMED USING GLOBAL POSITIONING SYSTEM PROCEDURES AND EQUIPMENT

THE BASIS OF BEARINGS IS GEODETIC NORTH DERIVED FROM G.P.S. OBSERVATIONS USING THE UTAH STATE G.P.S. VIRTUAL REFERENCE STATION CONTROL NETWORK MAINTAINED AND OPERATED BY THE AUTOMATED GEOGRAPHIC REFERENCE CENTER

SURVEYOR'S CERTIFICATE

This is to certify that this plat was prepared from the field notes and electronic data collector files of an actual survey made by me, or under my personal supervision, of the pipeline shown hereon, and that the monuments indicated were found or set during said survey, and that this plat accurately represents said survey to the best of my knowledge.

PROFESSIONAL LAND SURVEYOR No. 148951 JERRY D. ALLRED 18 JAN '14 STATE OF UTAH

Jerry D. Allred, Professional Land Surveyor, Certificate 148951 (Utah)

JERRY D. ALLRED & ASSOCIATES
SURVEYING CONSULTANTS
1235 NORTH 700 EAST--P.O. BOX 975
DUCHESNE, UTAH 84021
(435) 738-5352

18 JAN 2014 12-121-133

County Surveyors File # 2950