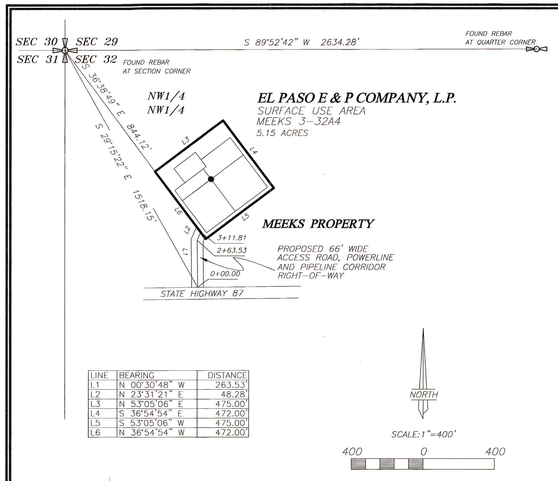

LINE	BEARING	DISTANCE
L1	N 00°30'48" W	263.53'
L2	N 23°31'21" E	48.28'
L3	N 53°05'06" E	475.00'
L4	S 36°54'54" E	472.00'
L5	S 53°05'06" W	475.00'
L6	N 36°54'54" W	472.00'

THIS SURVEY WAS PERFORMED USING GLOBAL POSITIONING SYSTEM PROCEDURES AND EQUIPMENT

THE BASIS OF GRID BEARINGS IS GEODETIC NORTH DERIVED FROM G.P.S. OBSERVATIONS AT THE NORTHWEST CORNER OF SECTION 32, 11S, R4W, U.S.B.&M. USING THE UTAH STATE G.P.S. VIRTUAL REFERENCE STATION CONTROL NETWORK MAINTAINED AND OPERATED BY THE AUTOMATED GEOGRAPHIC REFERENCE CENTER

LOCATION USE AREA AND
ACCESS ROAD, POWERLINE, AND PIPELINE
CORRIDOR RIGHT-OF-WAY SURVEY FOR

ELPASO E&P COMPANY, L.P.

MEEKS 3-32A4

NW¼NW¼ OF SECTION 32, 11S, R4W, U.S.B.&M.
DUCHESNE COUNTY, UTAH

USE AREA DESCRIPTION

Commencing at the Northwest Corner of Section 32, Township 1 South, Range 4 West of the Uintah Special Base and Meridian;
Thence South 36°38'49" East 844.12 feet to the TRUE POINT OF BEGINNING;
Thence North 53°05'06" East 475.00 feet;
Thence South 36°54'54" East 472.00 feet;
Thence South 53°05'06" West 475.00 feet;
Thence North 36°54'54" West 472.00 feet to the TRUE POINT OF BEGINNING, containing 5.15 acres.

ACCESS ROAD, POWER LINE, AND PIPELINE CORRIDOR RIGHT-OF-WAY DESCRIPTION

A 66 feet wide access road, pipeline and power line right-of way over portions of Section 32, Township 1 South, Range 4 West of the Uintah Special Base and Meridian, the centerline of said right-of-way being further described as follows:
Commencing at the Northwest Corner of said Section 32;
Thence South 29°15'22" East 1518.15 feet to the TRUE POINT OF BEGINNING, said point being on the North right-of-way line of State Highway 87;
Thence North 00°30'48" West 263.53 feet;
Thence North 23°31'21" East 48.28 feet to the South line of the Elpaso E&P Co. Meeks 3-32A4 well location surface use area boundary. Said right-of-way being 311.81 feet in length with the sidelines being shortened or elongated to intersect said use boundary and said North right-of-way lines.

SURVEYOR'S CERTIFICATE

This is to certify that this plat was prepared from the field notes and electronic data collector files of an actual survey made by me, or under my personal supervision, of the use area and access road, powerline, and pipeline corridor right-of-way shown hereon, and that the monuments indicated were found or set during said survey, and that this plat accurately represents said survey to the best of my knowledge.

PROFESSIONAL LAND SURVEYOR No. 148951 JERRY D. ALLRED 17 Mar '10 STATE OF UTAH

Jerry D. Allred, Professional Land Surveyor, Certificate 148951 (Utah)

JERRY D. ALLRED AND ASSOCIATES
SURVEYING CONSULTANTS
1235 NORTH 700 EAST--P.O. BOX 975
DUCHESNE, UTAH 84021
(435) 738-5352

12 JUN 2009 01-128-093

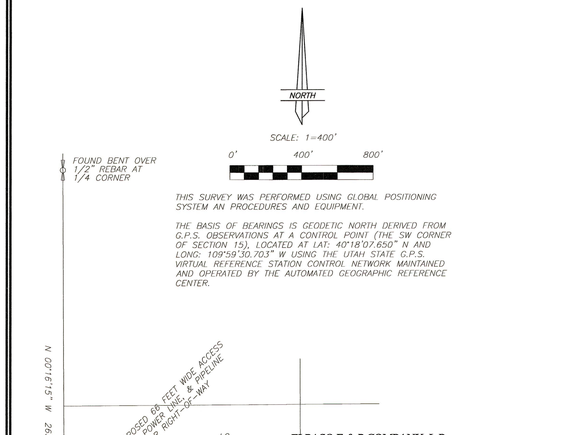

LINE	BEARING	DISTANCE
L1	N 00°00'00" E	472.00'
L2	S 90°00'00" E	475.00'
L3	S 00°00'00" E	472.00'
L4	N 90°00'00" W	475.00'

LOCATION SURFACE USE AREA &
ACCESS ROAD, PIPELINE AND POWER LINE RIGHT-OF-WAY
SURVEY FOR

EL PASO E & P COMPANY, L.P.

STAUFFER 2-11B1

SW¼SW¼ SECTION 11, TOWNSHIP 2 SOUTH, RANGE 1 WEST
UINTAH SPECIAL BASE AND MERIDIAN

THIS SURVEY WAS PERFORMED USING GLOBAL POSITIONING SYSTEM AN PROCEDURES AND EQUIPMENT.

THE BASIS OF BEARINGS IS GEODETIC NORTH DERIVED FROM G.P.S. OBSERVATIONS AT A CONTROL POINT (THE SW CORNER OF SECTION 15), LOCATED AT LAT: 40°18'07.650" N AND LONG: 109°59'30.703" W USING THE UTAH STATE G.P.S. VIRTUAL REFERENCE STATION CONTROL NETWORK MAINTAINED AND OPERATED BY THE AUTOMATED GEOGRAPHIC REFERENCE CENTER.

USE AREA BOUNDARY

Commencing at the SE Corner of Section 11, Township 2 South, Range 1 West of the Uintah Special Base and Meridian;
Thence North 45°39'14" East 910.14 feet to the TRUE POINT OF BEGINNING;
Thence North 00°00'00" East 472.00 feet;
Thence North 90°00'00" East 475.00 feet;
Thence South 00°00'00" East 472.00 feet;
Thence North 90°00'00" West 475.00 feet to the TRUE POINT OF BEGINNING, containing 5.15 acres.

ACCESS ROAD, PIPELINE AND POWER LINE CORRIDOR RIGHT-OF-WAY

A 66 feet wide access road, pipeline and power line corridor right-of-way over a portion of Section 11, Township 2 South, Range 1 West of the Uintah Special Base and Meridian, the centerline of which being described as follows:
Commencing at the SW Corner of said Section 11;
Thence North 02°08'01" East 786.57 feet to the East line of the existing county road and the TRUE POINT OF BEGINNING;
Thence North 89°59'47" East 621.58 feet to the West line of the El Paso E&P Co. Stauffer 2-11B3 well location use boundary. Said right-of-way being 621.58 feet in length, the side lines of which being shortened or elongated to meet the use area boundary and existing road right-of-way lines.

SURVEYOR'S CERTIFICATE

This is to certify that this plat was prepared from the field notes and electronic data collector files of an actual survey made by me, or under my personal supervision, of the use area, access road, pipeline and power line corridor right-of-way shown hereon, and that the monuments indicated were found or set during said survey, and that this plat accurately represents said survey to the best of my knowledge.

PROFESSIONAL LAND SURVEYOR No. 148951 JERRY D. ALLRED 17 Mar '10 STATE OF UTAH

Jerry D. Allred, Professional Land Surveyor, Certificate 148951 (Utah)

JERRY D. ALLRED AND ASSOCIATES
SURVEYING CONSULTANTS
1235 NORTH 700 EAST--P.O. BOX 975
DUCHESNE, UTAH 84021
(435) 738-5352

25 JUN 2009 01-128-094

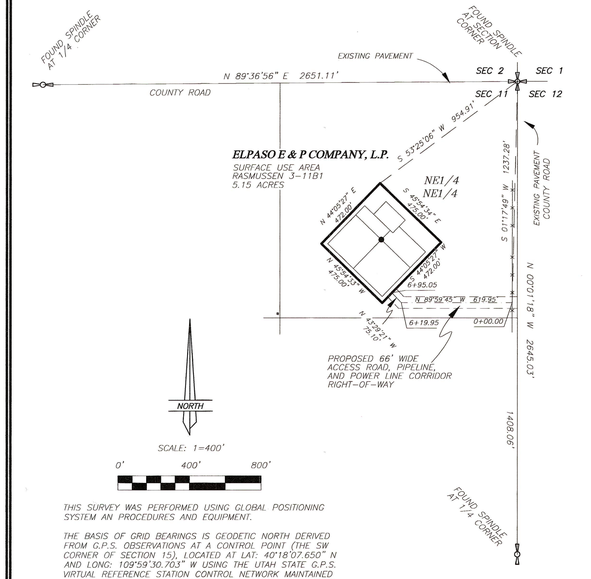

THIS SURVEY WAS PERFORMED USING GLOBAL POSITIONING SYSTEM PROCEDURES AND EQUIPMENT.

THE BASIS OF GRID BEARINGS IS GEODETIC NORTH DERIVED FROM G.P.S. OBSERVATIONS AT A CONTROL POINT (THE SW CORNER OF SECTION 15), LOCATED AT LAT: 40°18'07.650" N AND LONG: 109°59'30.703" W USING THE UTAH STATE G.P.S. VIRTUAL REFERENCE STATION CONTROL NETWORK MAINTAINED AND OPERATED BY THE AUTOMATED GEOGRAPHIC REFERENCE CENTER.

LOCATION SURFACE USE AREA, ACCESS ROAD,
PIPELINE AND POWER LINE CORRIDOR RIGHT-OF-WAY
SURVEY FOR

EL PASO E & P COMPANY, L.P.

RASMUSSEN 3-11B1

NE¼NE¼, SECTION 11, TOWNSHIP 2 SOUTH, RANGE 1 WEST
UINTAH SPECIAL BASE AND MERIDIAN

USE AREA BOUNDARY

Commencing at the NE Corner of Section 11, Township 2 South, Range 1 West of the Uintah Special Base and Meridian;
Thence South 53°25'06" West 954.91 feet to the TRUE POINT OF BEGINNING;
Thence South 45°54'34" East 475.00 feet;
Thence South 44°05'27" West 472.00 feet;
Thence North 45°54'33" West 475.00 feet;
Thence North 44°05'27" East 472.00 feet to the TRUE POINT OF BEGINNING, containing 5.15 acres.

ACCESS ROAD, PIPELINE AND POWER LINE CORRIDOR RIGHT-OF-WAY

A 66 feet wide access road, pipeline and power line corridor right-of-way over a portion of Section 11, Township 2 South, Range 1 West of the Uintah Special Base and Meridian, the centerline of which being described as follows:
Commencing at the NE Corner of said Section 11;
Thence South 01°17'49" West 1237.28 feet to the West line of the existing county road and the TRUE POINT OF BEGINNING;
Thence North 89°59'45" West 619.95 feet;
Thence North 4°29'21" West 75.10 feet to the East line of the El Paso E&P Co. Rasmussen 3-11B1 well location use boundary. Said right-of-way being 695.05 feet in length, the side lines of which being shortened or elongated to meet the use area boundary and existing road right-of-way lines.

SURVEYOR'S CERTIFICATE

This is to certify that this plat was prepared from the field notes and electronic data collector files of an actual survey made by me, or under my personal supervision, of the use area, access road, pipeline and power line corridor right-of-way shown hereon, and that the monuments indicated were found or set during said survey, and that this plat accurately represents said survey to the best of my knowledge.

PROFESSIONAL LAND SURVEYOR No. 148951 JERRY D. ALLRED 17 Mar '10 STATE OF UTAH

Jerry D. Allred, Professional Land Surveyor, Certificate 148951 (Utah)

JERRY D. ALLRED AND ASSOCIATES
SURVEYING CONSULTANTS
1235 NORTH 700 EAST--P.O. BOX 975
DUCHESNE, UTAH 84021
(435) 738-5352

23 JUN 2009 01-128-095

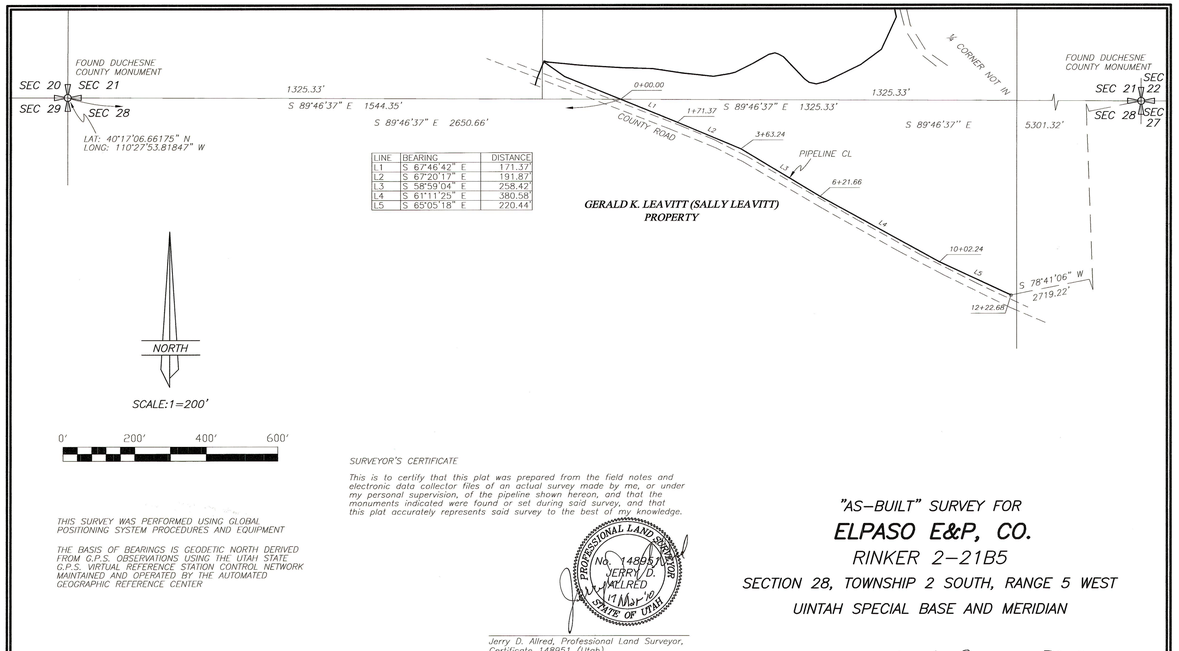

LINE	BEARING	DISTANCE
L2	S 67°20'17" E	191.87'
L3	S 58°59'04" E	258.42'
L4	S 61°11'25" E	380.58'
L5	S 65°05'18" E	220.44'

THIS SURVEY WAS PERFORMED USING GLOBAL POSITIONING SYSTEM PROCEDURES AND EQUIPMENT

THE BASIS OF BEARINGS IS GEODETIC NORTH DERIVED FROM G.P.S. OBSERVATIONS USING THE UTAH STATE G.P.S. VIRTUAL REFERENCE STATION CONTROL NETWORK MAINTAINED AND OPERATED BY THE AUTOMATED GEOGRAPHIC REFERENCE CENTER

SURVEYOR'S CERTIFICATE

This is to certify that this plat was prepared from the field notes and electronic data collector files of an actual survey made by me, or under my personal supervision, of the pipeline shown hereon, and that the monuments indicated were found or set during said survey, and that this plat accurately represents said survey to the best of my knowledge.

PROFESSIONAL LAND SURVEYOR No. 148951 JERRY D. ALLRED 17 Mar '10 STATE OF UTAH

Jerry D. Allred, Professional Land Surveyor, Certificate 148951 (Utah)

"AS-BUILT" SURVEY FOR

ELPASO E&P, CO.

RINKER 2-21B5

SECTION 28, TOWNSHIP 2 SOUTH, RANGE 5 WEST
UINTAH SPECIAL BASE AND MERIDIAN

County Surveyor's File #2222

JERRY D. ALLRED AND ASSOCIATES
SURVEYING CONSULTANTS
1235 NORTH 700 EAST--P.O. BOX 975
DUCHESNE, UTAH 84021
(435) 738-5352

3 FEB 2010 01-128-139