DRAWING NUMBER

SAFCO PRODUCTS • NEW HOPE, MINNESOTA
REORDER BY PART NUMBER 55051

DRAWING NUMBER 2009

SAFCO PRODUCTS • NEW HOPE, MINNESOTA
REORDER BY PART NUMBER 55051

DRAWING NUMBER

SAFCO PRODUCTS • NEW HOPE, MINNESOTA
REORDER BY PART NUMBER 55051

DRAWING NUMBER

SAFCO PRODUCTS • NEW HOPE, MINNESOTA
REORDER BY PART NUMBER 55051

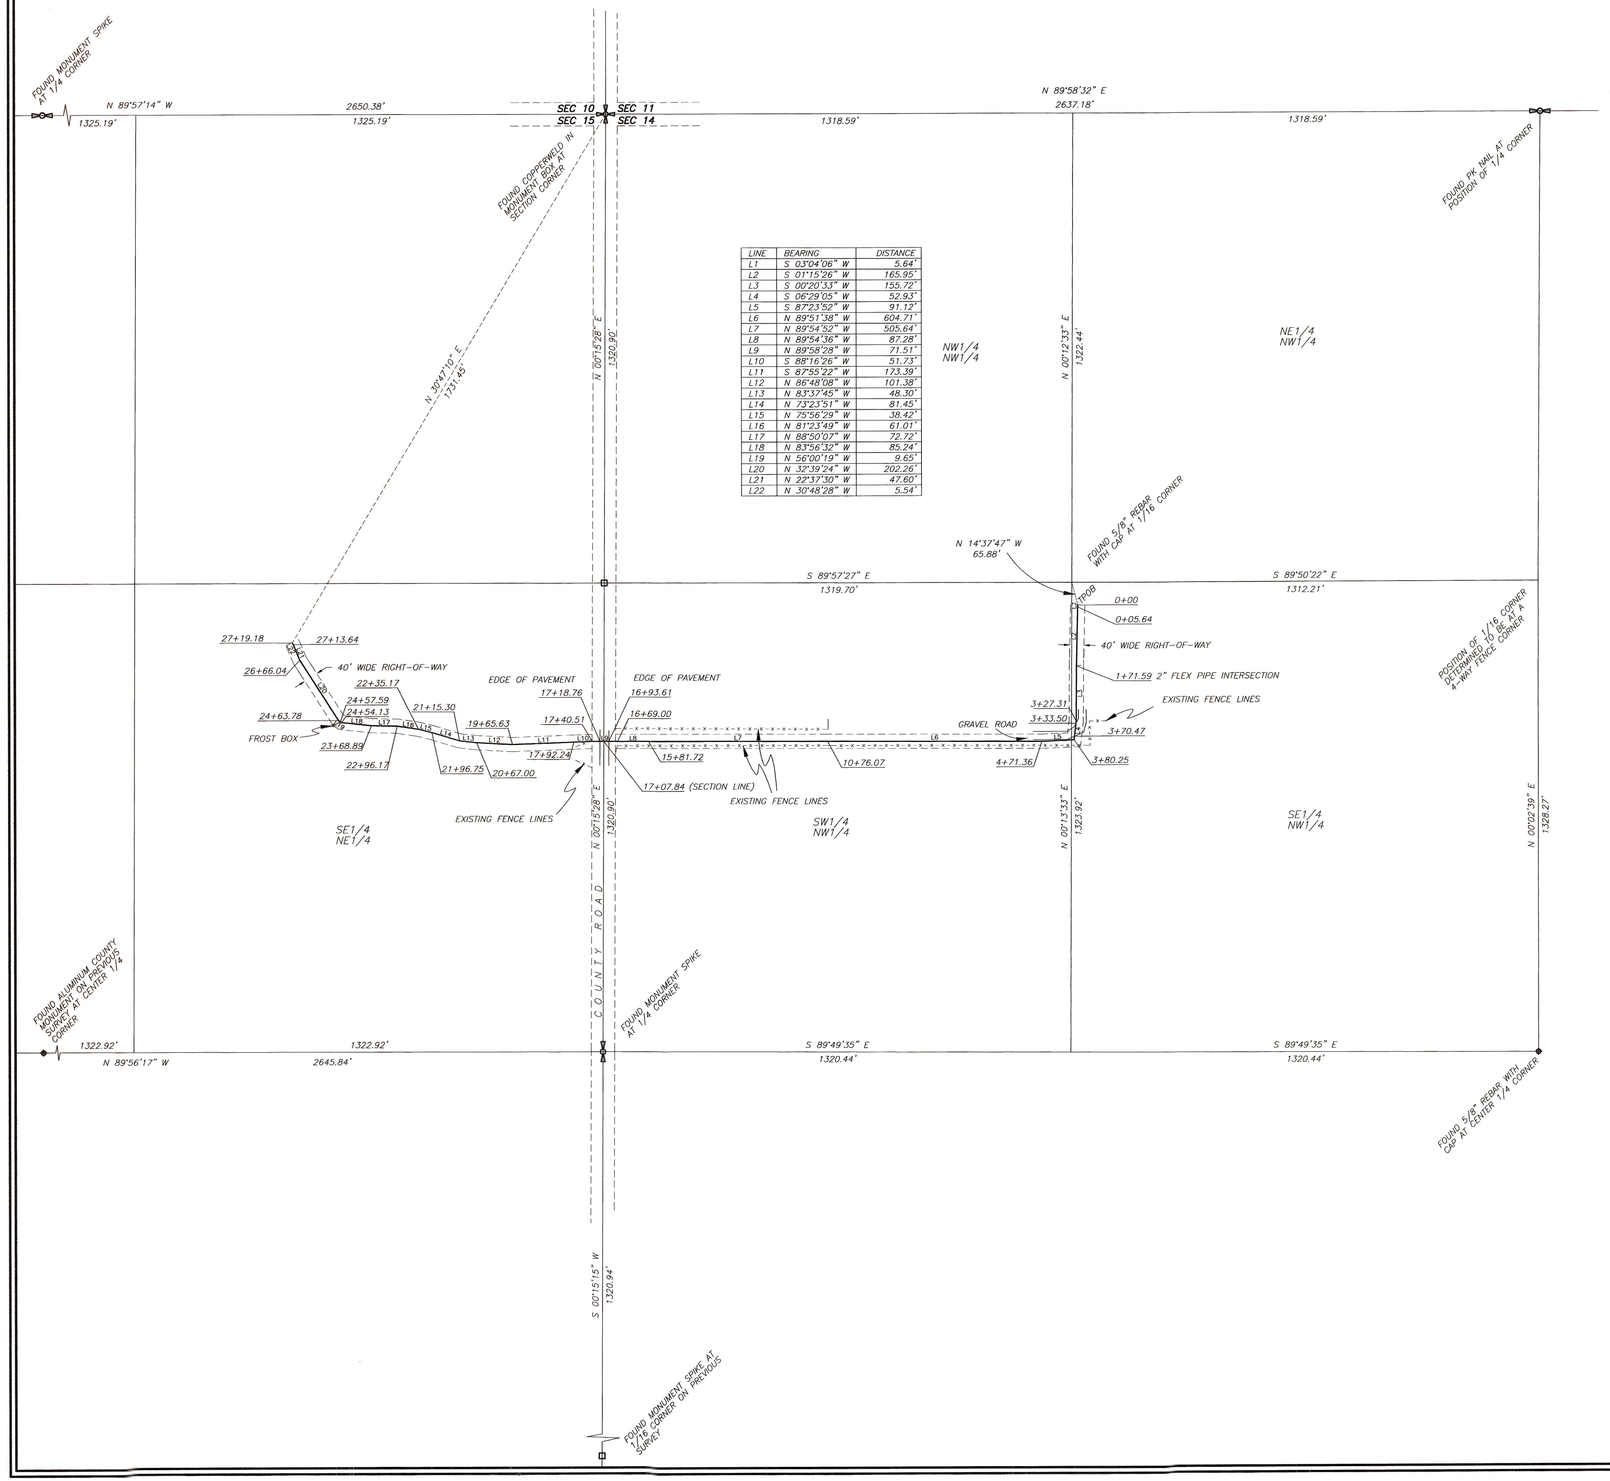

LINE	BEARING	DISTANCE
L1	S 0.3'04'06" W	5.64'
L2	S 01°15'26" W	165.95'
L3	S 00°20'33" W	155.72'
L4	S 06°29'05" W	52.93'
L5	S 87°23'52" W	91.12'
L6	N 89°51'38" W	604.71'
L7	N 89°54'52" W	505.64'
L8	N 89°54'36" W	87.28'
L9	N 89°58'28" W	71.51'
L10	S 88°16'26" W	51.73'
L11	S 87°55'22" W	173.39'
L12	N 86°48'08" W	101.38'
L13	N 83°37'45" W	48.30'
L14	N 73°23'51" W	81.45'
L15	N 75°56'29" W	38.42'
L16	N 81°23'49" W	61.01'
L17	N 88°50'07" W	72.72'
L18	N 83°56'32" W	85.24'
L19	N 56°00'19" W	9.65'
L20	N 32°39'24" W	202.26'
L21	N 22°37'30" W	47.60'
L22	N 30°48'28" W	5.54'

EL PASO E & P COMPANY, L.P.

PIPELINE AND "AS-BUILT" AND RIGHT-OF-WAY SURVEY

SECTIONS 14 & 15, TOWNSHIP 2 SOUTH, RANGE 1 WEST

UINTAH SPECIAL BASE AND MERIDIAN

NORTH

SCALE:1"=200'

0' 200' 400' 600'

THIS SURVEY WAS PERFORMED USING G.P.S. (GLOBAL POSITIONING SYSTEM) PROCEDURES AND EQUIPMENT. THE BASIS OF BEARINGS IS BASED ON WGS-84 DATUM.

CORRIDOR RIGHT-OF-WAY DESCRIPTION

A 40 foot wide right-of-way, 20 feet on each side of the following described centerline;
Commencing at the Northwest corner of the SE1/4 of the NW1/4 of Section 14, Township 2 South, Range 1 West of the Uintah Special Base And Meridian;
Thence South 14°37'47" East 65.88 feet to the TRUE POINT OF BEGINNING;
Thence South 0.3'04'06" West 5.64 feet;
Thence South 01°15'26" West 165.95 feet;
Thence South 00°20'33" West 155.72 feet;
Thence South 06°29'05" West 52.93 feet;
Thence South 87°23'52" West 91.12 feet;
Thence North 89°51'38" West 604.71 feet;
Thence North 89°54'52" West 505.64 feet;
Thence North 89°54'36" West 87.28 feet;
Thence North 89°58'28" West 71.51 feet;
Thence South 88°16'26" West 51.73 feet;
Thence South 87°55'22" West 173.39 feet;
Thence North 86°48'08" West 101.38 feet;
Thence North 83°37'45" West 48.30 feet;
Thence North 73°23'51" West 81.45 feet;
Thence North 75°56'29" West 38.42 feet;
Thence North 81°23'49" West 61.01 feet;
Thence North 88°50'07" West 72.72 feet;
Thence North 83°56'32" West 85.24 feet;
Thence North 56°00'19" West 9.65 feet;
Thence North 32°39'24" West 202.26 feet;
Thence North 22°37'30" West 47.60 feet;
Thence North 30°48'28" West 5.54 feet to an existing pipeline right-of-way;
to a point that is South 30°47'10" West 1731.45 feet from the Northwest corner of said Section 14, the basis of bearings is North 89°58'32" East between the Northwest Section corner and the North 1/4 corner of said Section 14.

NARRATIVE

The purpose of this survey was to map the location of an underground pipeline and to prepare a centerline description of a 40 feet wide right-of-way along said pipeline. The Public Land Survey System corners used to control the survey were found as indicated on the plat and have been accepted as the faithful representation of evidence of the original corner locations returned on the official General Land Office plat.

SURVEYOR'S CERTIFICATE

This is to certify that this plat was prepared from the field notes and electronic data collector files of an actual survey made by me, or under my personal supervision, of the parcel of land shown hereon, and that the monuments indicated were found or set during said survey, and that this plat accurately represents said survey to the best of my knowledge.

PROFESSIONAL LAND SURVEYOR
No. 148951
JERRY D. ALLRED
21 Apr 08
STATE OF UTAH

Jerry D. Allred, Professional Land Surveyor
Utah Certificate Number 148951

COUNTY SURVEYOR'S FILE # 2009

JERRY D. ALLRED AND ASSOCIATES
SURVEYING CONSULTANTS
121 NORTH CENTER ST.--P.O. BOX 975
DUCHESNE, UTAH 84021
(435) 738-5352

8 MAR 2008 01-128-039