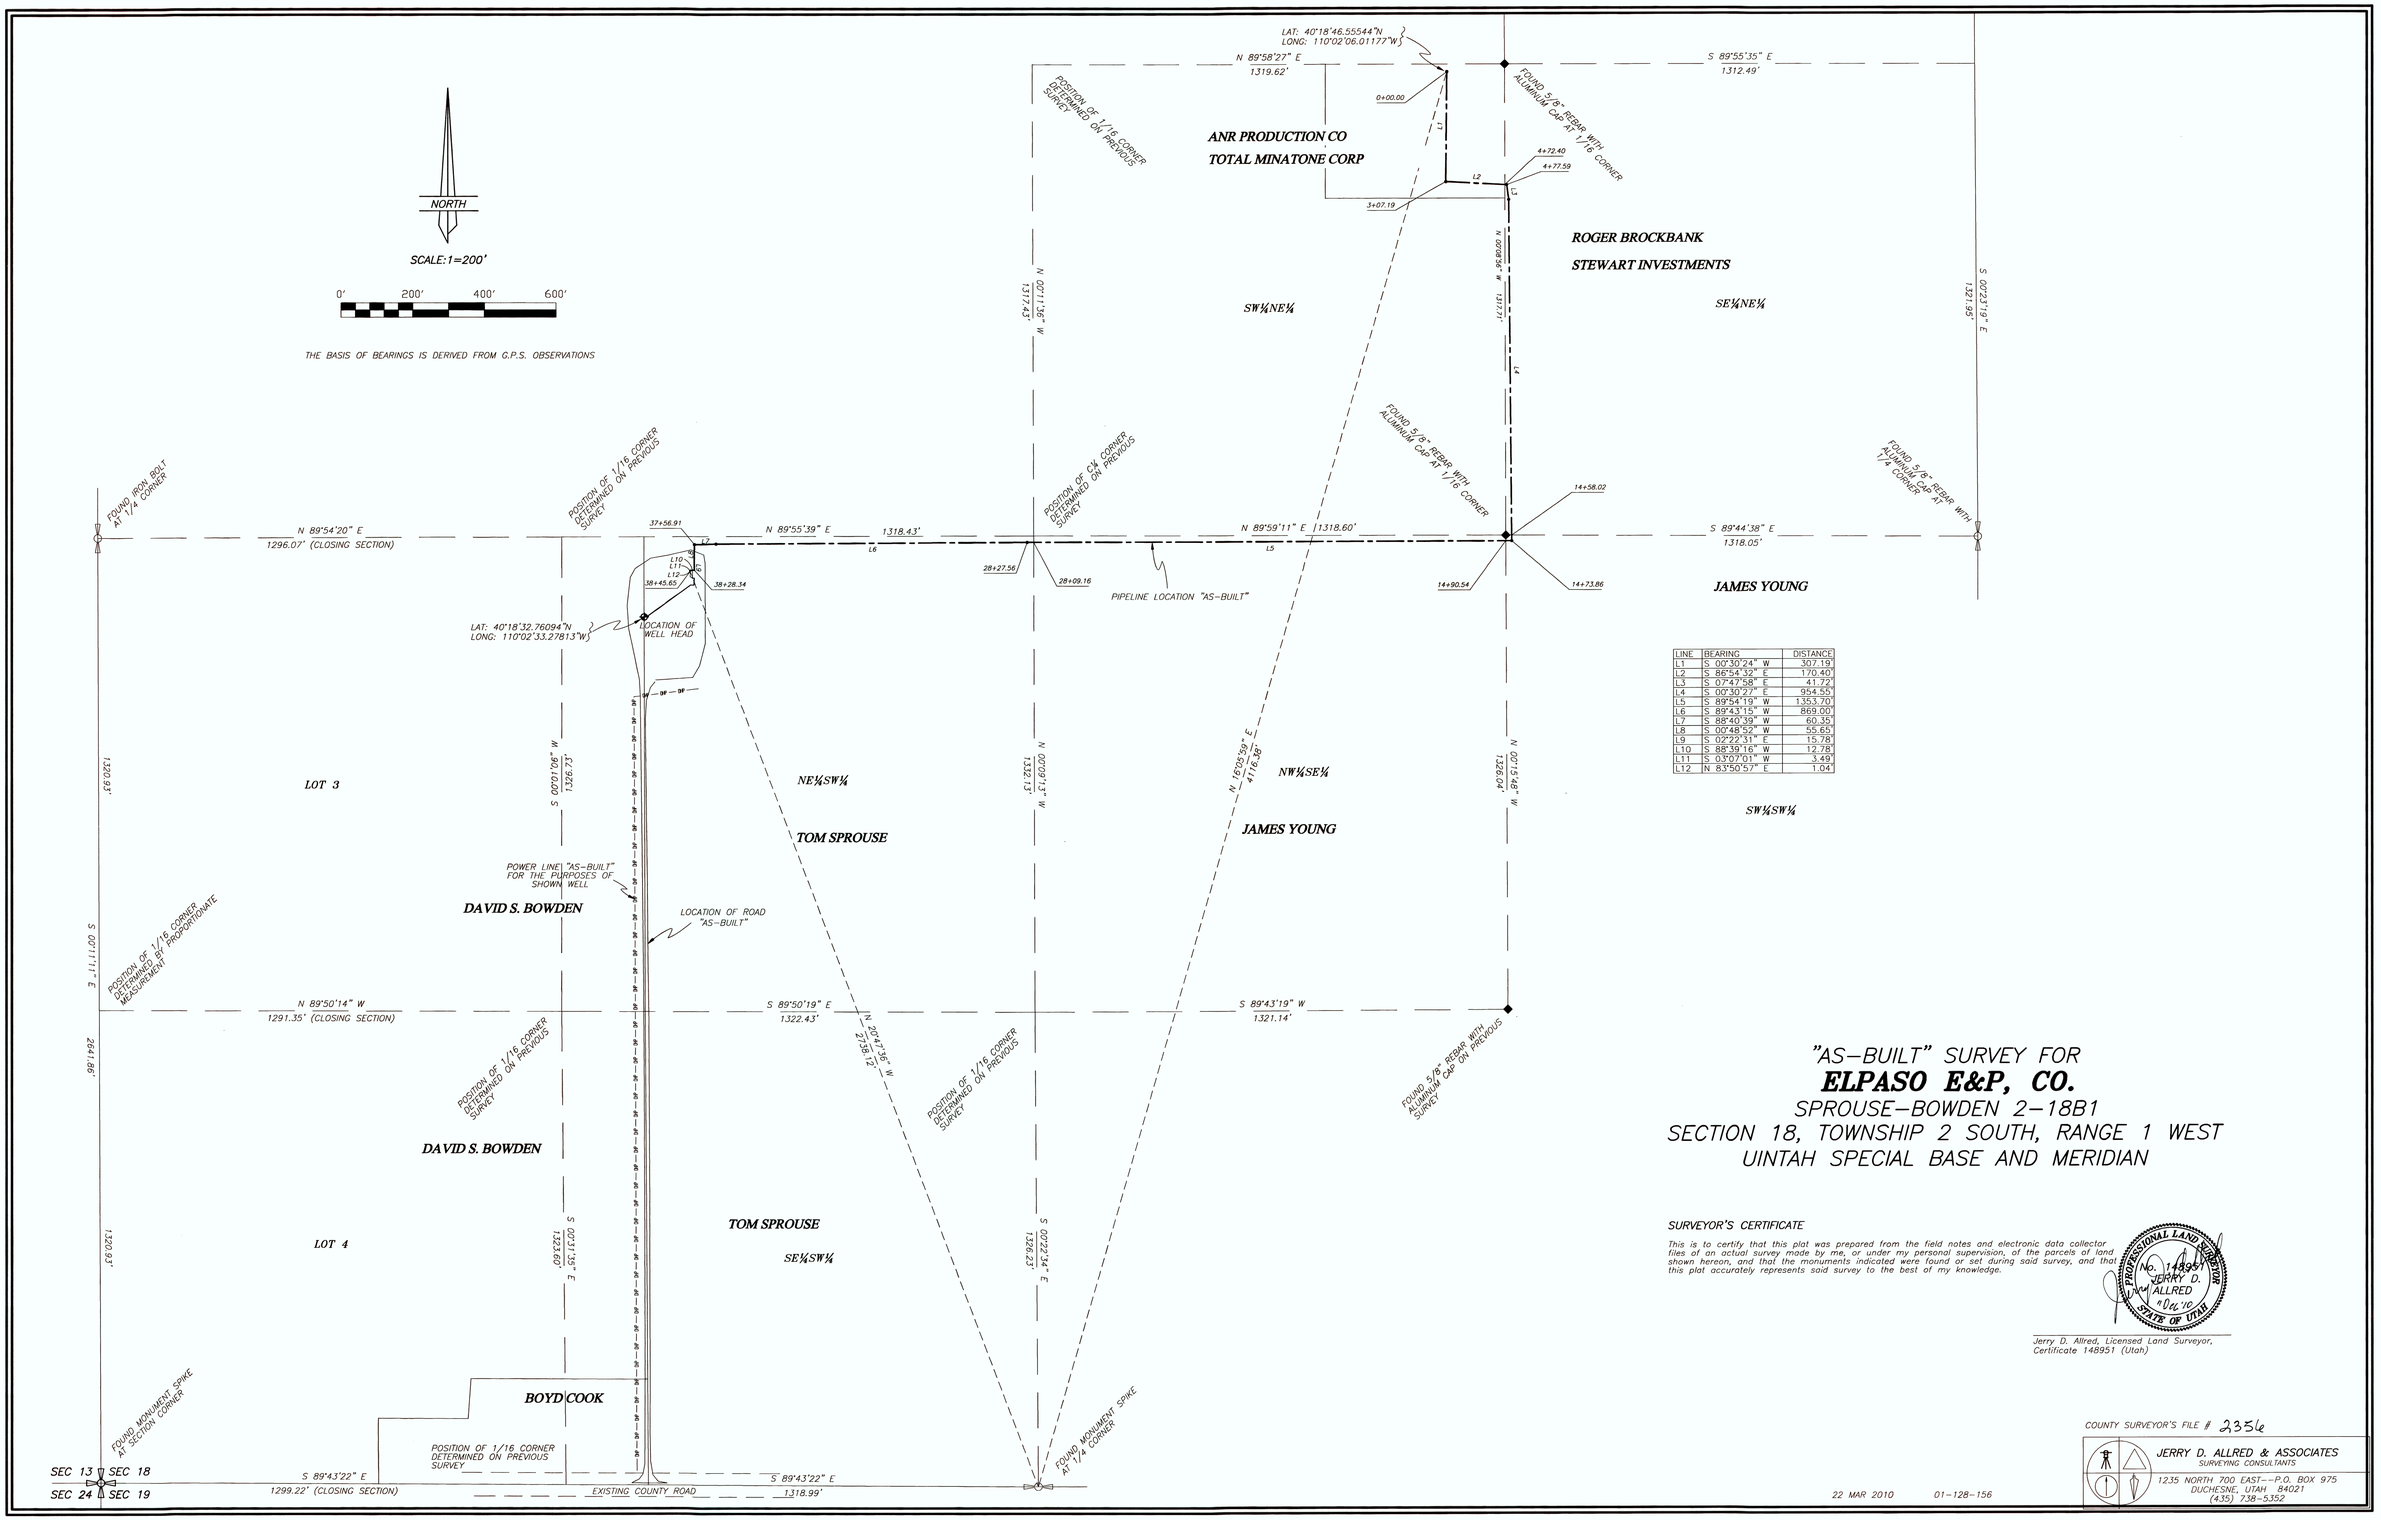

LINE	BEARING	DISTANCE
L1	S 00°30'24" W	307.19'
L2	S 86°54'32" E	170.40'
L3	S 07°47'58" E	41.72'
L4	S 00°30'27" E	954.55'
L5	S 89°54'19" W	1353.70'
L6	S 89°43'15" W	869.00'
L7	S 88°40'39" W	60.35'
L8	S 00°48'52" W	55.65'
L9	S 02°22'31" E	15.78'
L10	S 88°39'16" W	12.78'
L11	S 03°07'01" W	3.49'
L12	N 83°50'57" E	1.04'

"AS-BUILT" SURVEY FOR
ELPASO E&P, CO.
SPROUSE-BOWDEN 2-18B1
SECTION 18, TOWNSHIP 2 SOUTH, RANGE 1 WEST
UINTAH SPECIAL BASE AND MERIDIAN

SURVEYOR'S CERTIFICATE

This is to certify that this plat was prepared from the field notes and electronic data collector files of an actual survey made by me, or under my personal supervision, of the parcels of land shown hereon, and that the monuments indicated were found or set during said survey, and that this plat accurately represents said survey to the best of my knowledge.

PROFESSIONAL LAND SURVEYOR No. 148951 JERRY D. ALLRED STATE OF UTAH

Jerry D. Allred, Licensed Land Surveyor, Certificate 148951 (Utah)

COUNTY SURVEYOR'S FILE # 2356

JERRY D. ALLRED & ASSOCIATES
SURVEYING CONSULTANTS
1235 NORTH 700 EAST--P.O. BOX 975
DUCHESNE, UTAH 84021
(435) 738-5352

22 MAR 2010 01-128-156