PIPELINE "AS-BUILT" SURVEY FOR

ELPASO E&P, CO.

SECTIONS 30 AND 31, TOWNSHIP 2 SOUTH, RANGE 4 WEST
SECTIONS 6 AND 7, TOWNSHIP 3 SOUTH, RANGE 4 WEST
SECTION 12, TOWNSHIP 3 SOUTH, RANGE 5 WEST
UINTAH SPECIAL BASE AND MERIDIAN

NORTH

SCALE: 1"=600'

0' 600' 1200' 1800'

- HIGHWAY RIGHT-OF-WAY MARKERS
- CARSONITE PIPELINE MARKERS

NARRATIVE

This "as-built" survey was performed at the request of Elpaso E&P Co. for the purpose of locating the position of an existing pipeline. The monuments marking the Public Land Survey System corners were found as indicated and used to control the survey.

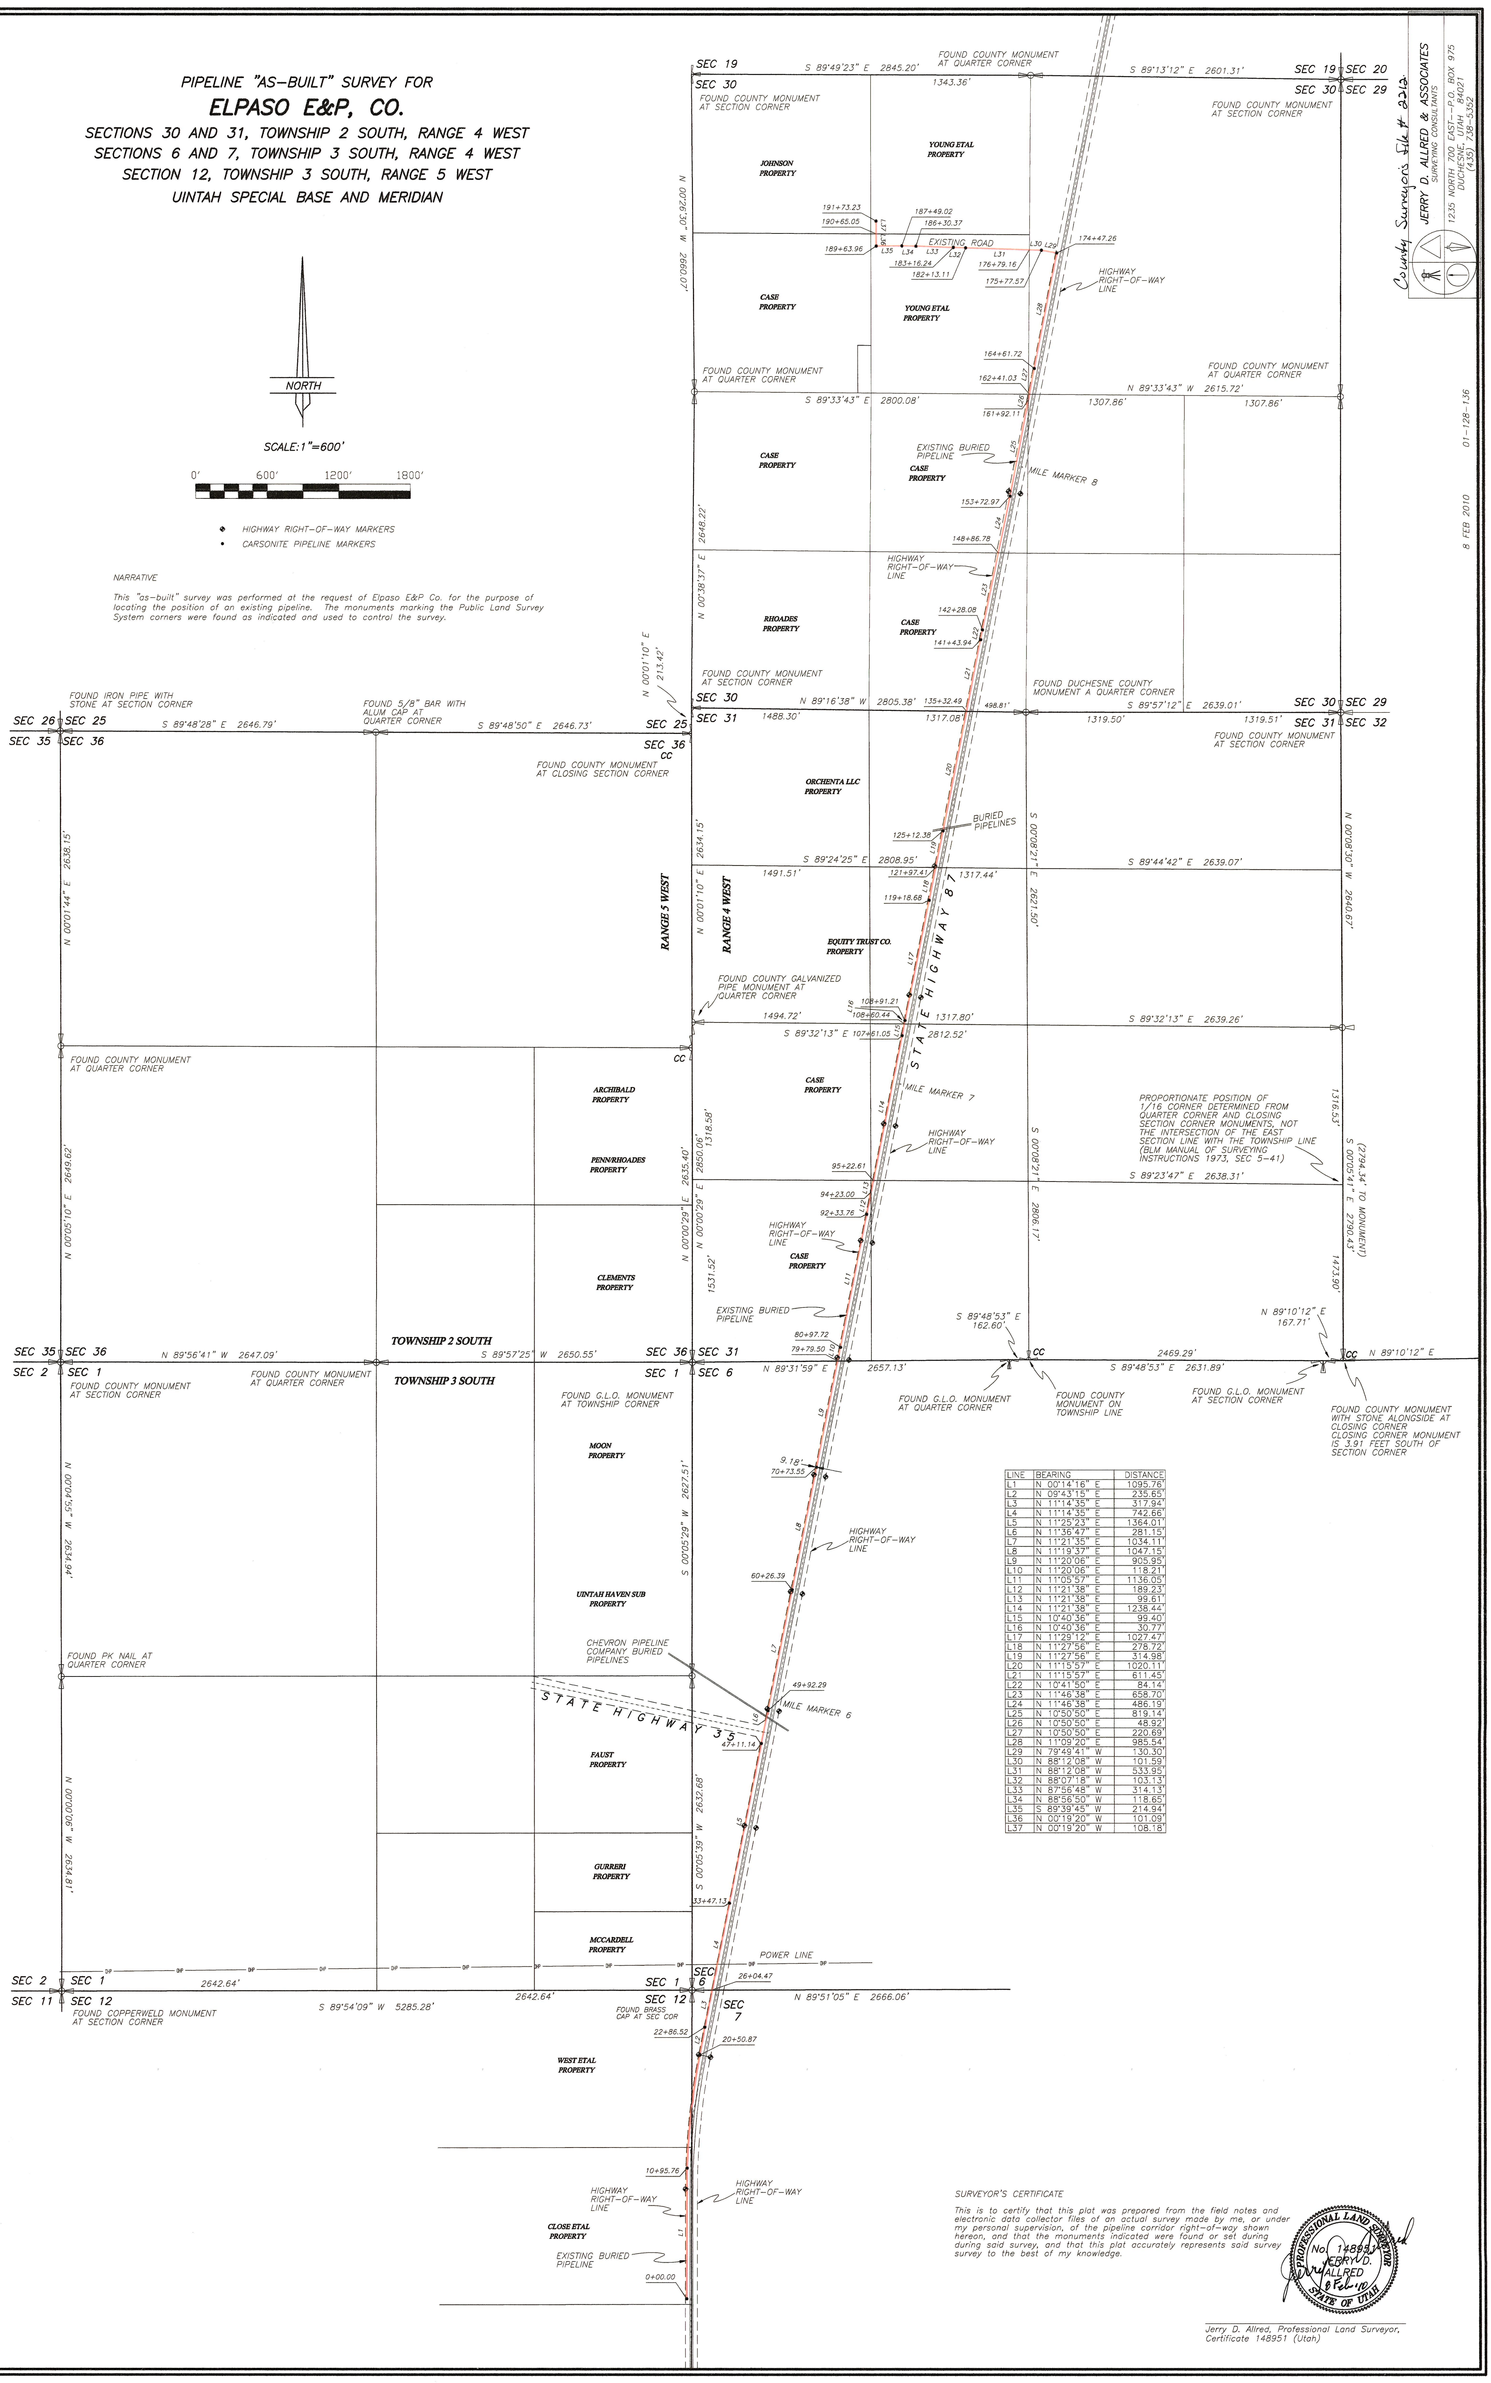

LINE	BEARING	DISTANCE
L1	N 00°14'16" E	1095.76
L2	N 09°43'15" E	235.62
L3	N 11°14'35" E	317.94
L4	N 11°14'35" E	742.66
L5	N 11°25'23" E	1,364.01
L6	N 11°36'47" E	281.15
L7	N 11°21'35" E	1034.11
L8	N 11°19'37" E	1047.15
L9	N 11°20'06" E	905.95
L10	N 11°20'06" E	118.21
L11	N 11°05'57" E	1136.05
L12	N 11°21'38" E	189.23
L13	N 11°21'38" E	99.61
L14	N 11°21'38" E	1238.44
L15	N 10°40'36" E	99.40
L16	N 10°40'36" E	30.77
L17	N 11°29'12" E	1027.47
L18	N 11°27'56" E	278.72
L19	N 11°27'56" E	314.98
L20	N 11°15'57" E	1020.11
L21	N 11°15'57" E	611.45
L22	N 10°41'50" E	84.14
L23	N 11°46'38" E	658.70
L24	N 11°46'38" E	486.19
L25	N 10°50'50" E	819.14
L26	N 10°50'50" E	48.92
L27	N 10°50'50" E	220.69
L28	N 11°09'20" E	985.54
L29	N 79°49'41" W	130.30
L30	N 88°12'08" W	101.59
L31	N 88°12'08" W	533.95
L32	N 88°07'18" W	103.13
L33	N 87°56'48" W	314.13
L34	N 88°56'50" W	118.65
L35	S 89°39'45" W	214.94
L36	N 00°19'20" W	101.09
L37	N 00°19'20" W	108.18