PIPELINE AS-BUILT SURVEY FOR

KINDER MORGAN ALTAMONT, LLC.

LAKE FORK RANCH 4-24B4

SECTION 24, T2S, R4W, U.S.B.&M.

DUCHESNE COUNTY, UTAH

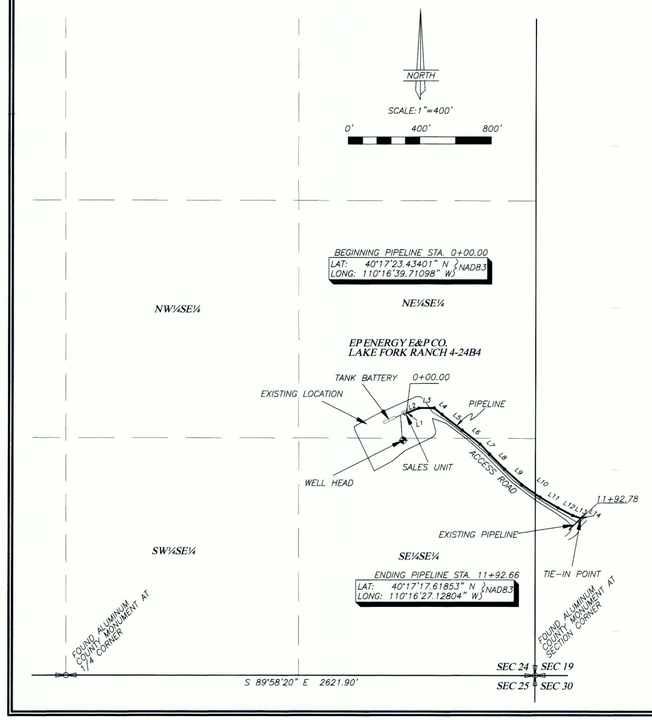

LINE	BEARING	DISTANCE
L1	N 76°48'31" E	10.54'
L2	N 66°45'40" E	62.41'
L3	N 89°38'52" E	85.91'
L4	S 51°13'12" E	57.60'
L5	S 52°20'44" E	142.33'
L6	S 52°08'21" E	127.24'
L7	S 43°58'53" E	76.66'
L8	S 45°01'31" E	119.19'
L9	S 48°18'10" E	128.92'
L10	S 55°22'20" E	125.02'
L11	S 59°31'17" E	117.05'
L12	S 62°09'41" E	90.62'
L13	S 70°12'00" E	45.14'
L14	S 62°09'26" E	4.15'

THIS SURVEY WAS PERFORMED USING GLOBAL POSITIONING SYSTEM PROCEDURES AND EQUIPMENT

THE BASIS OF BEARINGS IS GEODETIC NORTH DERIVED FROM G.P.S. OBSERVATIONS AT A CONTROL POINT LOCATED AT LAT. 40°21'33.56882"N AND LONG. 110°16'31.53266"W USING THE UTAH STATE G.P.S. VIRTUAL REFERENCE STATION CONTROL NETWORK MAINTAINED AND OPERATED BY THE AUTOMATED GEOGRAPHIC REFERENCE CENTER

SURVEYOR'S CERTIFICATE

This is to certify that this plat was prepared from the field notes and electronic data collector files of an actual survey made by me, or under my personal supervision of the pipeline shown hereon, and that the monuments indicated were found or set during said survey, and that this plat accurately represents said survey to the best of my knowledge.

PROFESSIONAL LAND SURVEYOR No. 148951 JERRY D. ALLRED 3 DEC '13 STATE OF UTAH

JERRY D. ALLRED, REGISTERED LAND SURVEYOR, CERTIFICATE NO. 148951 (UTAH)

COUNTY SURVEYOR'S FILE NUMBER

JERRY D. ALLRED AND ASSOCIATES
SURVEYING CONSULTANTS
1235 NORTH 700 EAST---P.O. BOX 975
DUCHESNE, UTAH 84021
(435) 738-5352

3 DEC 2013 12-121-092

PIPELINE AS-BUILT SURVEY FOR

KINDER MORGAN ALTAMONT, LLC.

LAKE FORK RANCH 4-23B4

SECTION 23, T2S, R4W, U.S.B.&M.

DUCHESNE COUNTY, UTAH

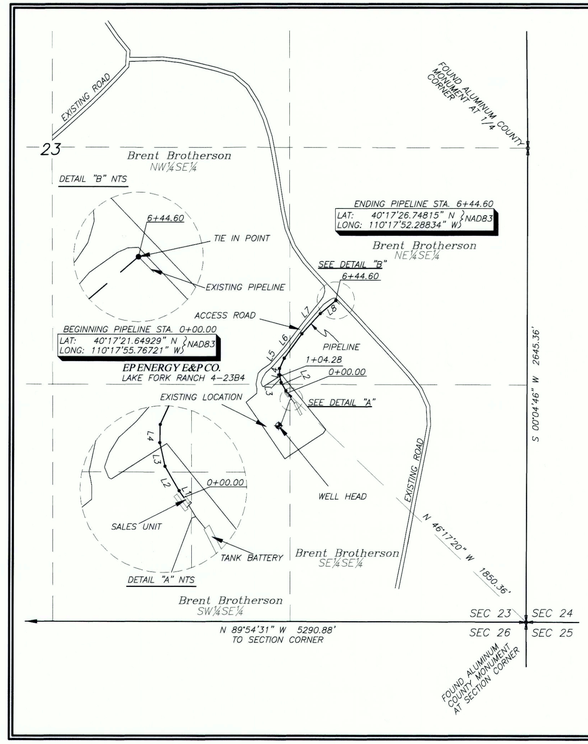

LINE	BEARING	DISTANCE
L1	N 35°18'14" W	15.34'
L2	N 30°06'16" W	52.61'
L3	N 12°33'45" W	45.01'
L4	N 01°02'32" E	34.15'
L5	N 24°34'10" E	62.83'
L6	N 35°57'57" E	168.77'
L7	N 42°09'10" E	151.70'
L8	N 49°45'53" E	114.20'

SURVEYOR'S CERTIFICATE

This is to certify that this plat was prepared from the field notes and electronic data collector files of an actual survey made by me, or under my personal supervision of the pipeline shown hereon, and that the monuments indicated were found or set during said survey, and that this plat accurately represents said survey to the best of my knowledge.

PROFESSIONAL LAND SURVEYOR No. 148951 JERRY D. ALLRED 2 JAN '14 STATE OF UTAH

JERRY D. ALLRED, REGISTERED LAND SURVEYOR, CERTIFICATE NO. 148951 (UTAH)

COUNTY SURVEYOR'S FILE NUMBER

JERRY D. ALLRED AND ASSOCIATES
SURVEYING CONSULTANTS
1235 NORTH 700 EAST---P.O. BOX 975
DUCHESNE, UTAH 84021
(435) 738-5352

2 JAN 2014 12-121-120

PIPELINE AS-BUILT SURVEY FOR

KINDER MORGAN ALTAMONT, LLC.

BARRETT 14-8D-36 BTR

SECTION 8, T3S, R6W, U.S.B.&M.

DUCHESNE COUNTY, UTAH

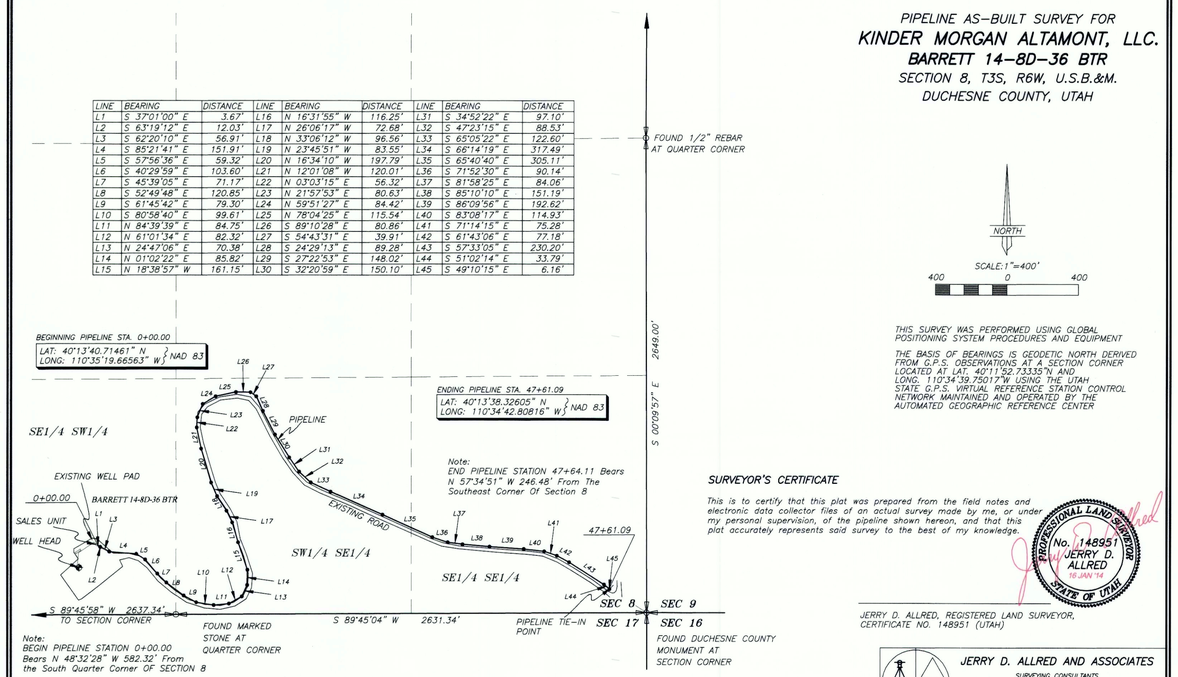

LINE	BEARING	DISTANCE	LINE	BEARING	DISTANCE	LINE	BEARING	DISTANCE
L1	S 37°01'00" E	3.67'	L16	N 16°31'55" W	116.25'	L31	S 34°52'22" E	97.10'
L2	S 63°19'12" E	12.03'	L17	N 26°06'17" W	72.68'	L32	S 47°23'15" E	88.53'
L3	S 62°20'10" E	56.91'	L18	N 33°06'12" W	96.56'	L33	S 65°05'22" E	122.60'
L4	S 85°21'41" E	151.91'	L19	N 23°45'51" W	83.55'	L34	S 66°14'19" E	317.46'
L5	S 57°56'36" E	59.32'	L20	N 16°34'10" W	197.79'	L35	S 65°40'40" E	305.11'
L6	S 40°29'59" E	103.60'	L21	N 12°01'08" W	120.01'	L36	S 71°52'30" E	90.14'
L7	S 45°39'05" E	71.17'	L22	N 03°03'15" E	56.32'	L37	S 81°58'25" E	84.06'
L8	S 52°49'48" E	120.85'	L23	N 21°57'53" E	80.63'	L38	S 85°10'10" E	151.19'
L9	S 61°45'42" E	79.30'	L24	N 59°51'27" E	84.42'	L39	S 86°09'56" E	192.62'
L10	S 80°58'40" E	99.61'	L25	N 78°04'25" E	115.54'	L40	S 83°08'17" E	114.93'
L11	N 84°39'39" E	84.75'	L26	S 89°10'28" E	80.86'	L41	S 71°14'15" E	75.28'
L12	N 61°01'34" E	82.32'	L27	S 54°43'31" E	39.91'	L42	S 61°43'06" E	77.18'
L13	N 24°47'06" E	70.38'	L28	S 24°29'13" E	89.28'	L43	S 57°33'05" E	230.20'
L14	N 01°02'22" E	85.82'	L29	S 27°22'53" E	148.02'	L44	S 51°02'14" E	33.79'
L15	N 18°38'57" W	161.15'	L30	S 32°20'59" E	150.10'	L45	S 49°10'15" E	6.16'

THIS SURVEY WAS PERFORMED USING GLOBAL POSITIONING SYSTEM PROCEDURES AND EQUIPMENT

THE BASIS OF BEARINGS IS GEODETIC NORTH DERIVED FROM G.P.S. OBSERVATIONS AT A SECTION CORNER LOCATED AT LAT. 40°11'52.73335"N AND LONG. 110°34'39.75017"W USING THE UTAH STATE G.P.S. VIRTUAL REFERENCE STATION CONTROL NETWORK MAINTAINED AND OPERATED BY THE AUTOMATED GEOGRAPHIC REFERENCE CENTER

SURVEYOR'S CERTIFICATE

This is to certify that this plat was prepared from the field notes and electronic data collector files of an actual survey made by me, or under my personal supervision, of the pipeline shown hereon, and that this plat accurately represents said survey to the best of my knowledge.

PROFESSIONAL LAND SURVEYOR No. 148951 JERRY D. ALLRED 16 JAN '14 STATE OF UTAH

JERRY D. ALLRED, REGISTERED LAND SURVEYOR, CERTIFICATE NO. 148951 (UTAH)

JERRY D. ALLRED AND ASSOCIATES
SURVEYING CONSULTANTS
1235 NORTH 700 EAST---P.O. BOX 975
DUCHESNE, UTAH 84021
(435) 738-5352

16 JAN 2014 12-121-128

PIPELINE AS-BUILT SURVEY FOR

KINDER MORGAN ALTAMONT, LLC.

BARRETT 14-29-36 BTR

SECTIONS 29 & 30, T3S, R6W, U.S.B.&M.

DUCHESNE COUNTY, UTAH

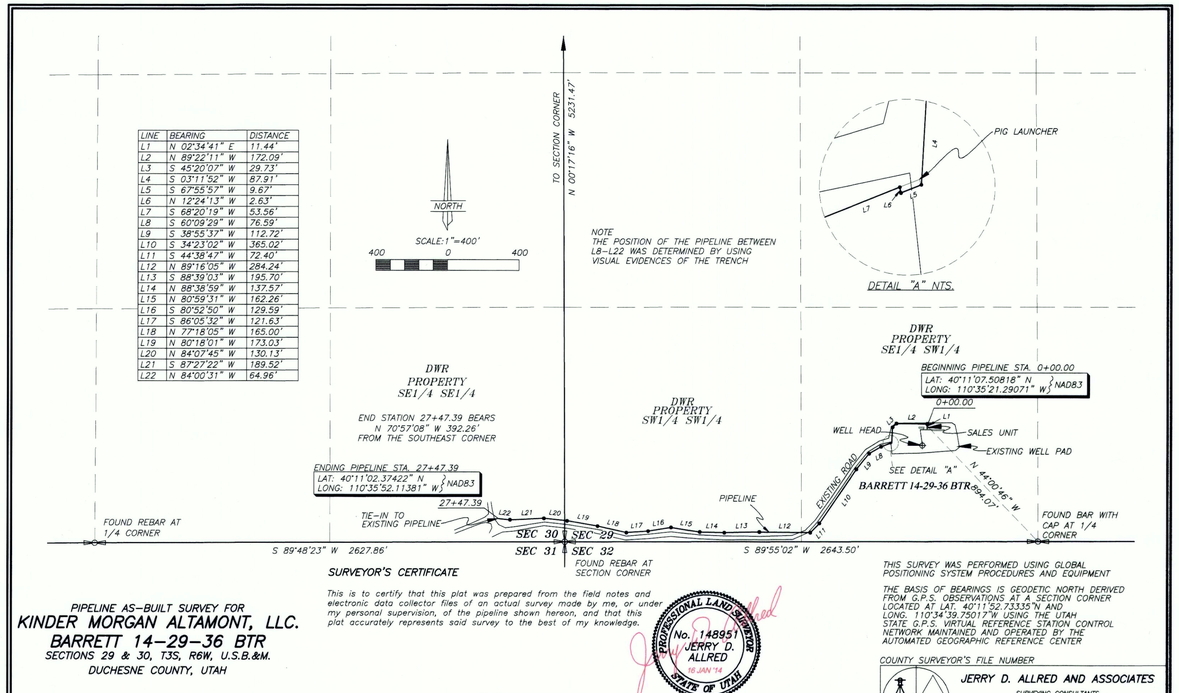

LINE	BEARING	DISTANCE
L1	N 02°34'41" E	11.44'
L2	N 89°22'11" W	172.09'
L3	S 45°20'07" W	29.73'
L4	S 03°11'52" W	87.91'
L5	S 67°55'53" W	9.67'
L6	N 12°24'13" W	2.63'
L7	S 68°20'19" W	53.56'
L8	S 60°09'29" W	76.59'
L9	S 38°55'37" W	112.72'
L10	S 34°23'02" W	365.02'
L11	S 44°38'47" W	72.40'
L12	N 89°16'05" W	284.24'
L13	S 88°39'03" W	195.70'
L14	N 88°38'59" W	137.57'
L15	N 80°59'31" W	162.26'
L16	S 80°52'50" W	129.59'
L17	S 86°05'32" W	121.63'
L18	N 77°18'05" W	165.00'
L19	N 80°18'01" W	173.03'
L20	N 84°07'45" W	130.13'
L21	S 87°27'22" W	189.52'
L22	N 84°00'31" W	64.96'

SURVEYOR'S CERTIFICATE

This is to certify that this plat was prepared from the field notes and electronic data collector files of an actual survey made by me, or under my personal supervision, of the pipeline shown hereon, and that this plat accurately represents said survey to the best of my knowledge.

PROFESSIONAL LAND SURVEYOR No. 148951 JERRY D. ALLRED 16 JAN '14 STATE OF UTAH

JERRY D. ALLRED, REGISTERED LAND SURVEYOR, CERTIFICATE NO. 148951 (UTAH)

COUNTY SURVEYOR'S FILE NUMBER

JERRY D. ALLRED AND ASSOCIATES
SURVEYING CONSULTANTS
1235 NORTH 700 EAST---P.O. BOX 975
DUCHESNE, UTAH 84021
(435) 738-5352

16 JAN 2014 12-121-129

County Surveyors File # 2929