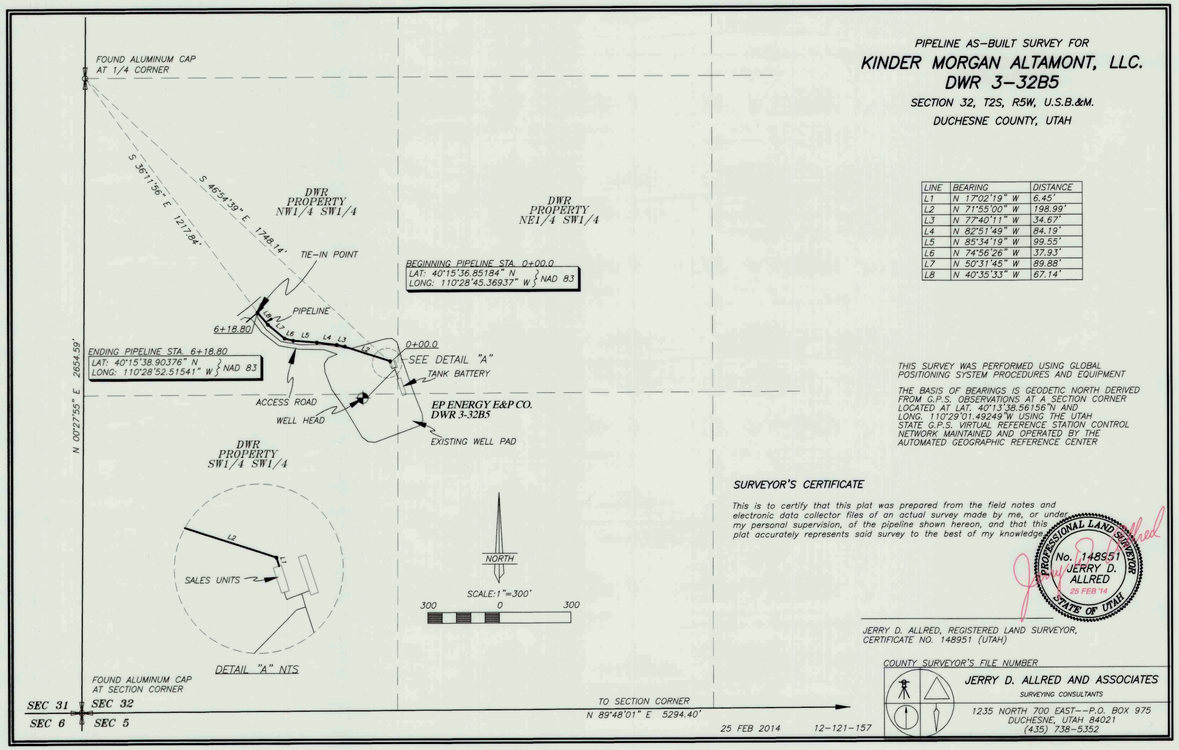

LINE	BEARING	DISTANCE
L1	N 17°02'19" W	6.45'
L2	N 71°55'00" W	198.99'
L3	N 77°40'11" W	34.67'
L4	N 82°51'49" W	84.19'
L5	N 85°34'19" W	99.55'
L6	N 74°56'26" W	37.93'
L7	N 50°31'45" W	89.88'
L8	N 40°35'33" W	67.14'

PIPELINE AS-BUILT SURVEY FOR

KINDER MORGAN ALTAMONT, LLC.

DWR 3-32B5

SECTION 32, T2S, R5W, U.S.B.&M.

DUCHESNE COUNTY, UTAH

THIS SURVEY WAS PERFORMED USING GLOBAL POSITIONING SYSTEM PROCEDURES AND EQUIPMENT

THE BASIS OF BEARINGS IS GEODETIC NORTH DERIVED FROM G.P.S. OBSERVATIONS AT A SECTION CORNER LOCATED AT LAT. 40°13'38.56156"N AND LONG. 110°29'01.49249"W USING THE UTAH STATE G.P.S. VIRTUAL REFERENCE STATION CONTROL NETWORK MAINTAINED AND OPERATED BY THE AUTOMATED GEOGRAPHIC REFERENCE CENTER

SURVEYOR'S CERTIFICATE

This is to certify that this plat was prepared from the field notes and electronic data collector files of an actual survey made by me, or under my personal supervision, of the pipeline shown hereon, and that this plat accurately represents said survey to the best of my knowledge.

PROFESSIONAL LAND SURVEYOR No. 148951 JERRY D. ALLRED 25 FEB '14 STATE OF UTAH

JERRY D. ALLRED, REGISTERED LAND SURVEYOR, CERTIFICATE NO. 148951 (UTAH)

COUNTY SURVEYOR'S FILE NUMBER

JERRY D. ALLRED AND ASSOCIATES
SURVEYING CONSULTANTS
1235 NORTH 700 EAST--P.O. BOX 975
DUCHESNE, UTAH 84021
(435) 738-5352

25 FEB 2014 12-121-157

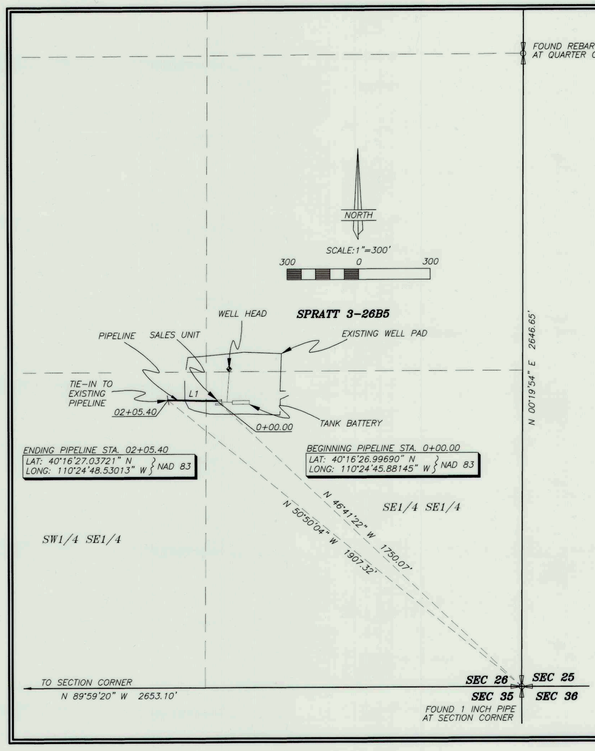

LINE	BEARING	DISTANCE
L1	N 88°50'55" W	205.40

PIPELINE AS-BUILT SURVEY FOR

KINDER MORGAN ALTAMONT, LLC.

SPRATT 3-26B5

SECTION 26, TOWNSHIP 2 SOUTH, RANGE 5 WEST

UINTAH SPECIAL BASE & MERIDIAN

THIS SURVEY WAS PERFORMED USING GLOBAL POSITIONING SYSTEM PROCEDURES AND EQUIPMENT

THE BASIS OF BEARINGS IS GEODETIC NORTH DERIVED FROM G.P.S. OBSERVATIONS AT A SECTION CORNER LOCATED AT LAT. 40°15'22.90258"N AND LONG. 110°23'21.19760"W USING THE UTAH STATE G.P.S. VIRTUAL REFERENCE STATION CONTROL NETWORK MAINTAINED AND OPERATED BY THE AUTOMATED GEOGRAPHIC REFERENCE CENTER

SURVEYOR'S CERTIFICATE

This is to certify that this plat was prepared from the field notes and electronic data collector files of an actual survey made by me, or under my personal supervision, of the pipeline shown hereon, and that this plat accurately represents said survey to the best of my knowledge.

PROFESSIONAL LAND SURVEYOR No. 148951 JERRY D. ALLRED 27 JAN '14 STATE OF UTAH

JERRY D. ALLRED, REGISTERED LAND SURVEYOR, CERTIFICATE NO. 148951 (UTAH)

COUNTY SURVEYORS FILE NUMBER:

JERRY D. ALLRED AND ASSOCIATES
SURVEYING CONSULTANTS
1235 NORTH 700 EAST--P.O. BOX 975
DUCHESNE, UTAH 84021
(435) 738-5352

27 JAN 2014 12-121-145

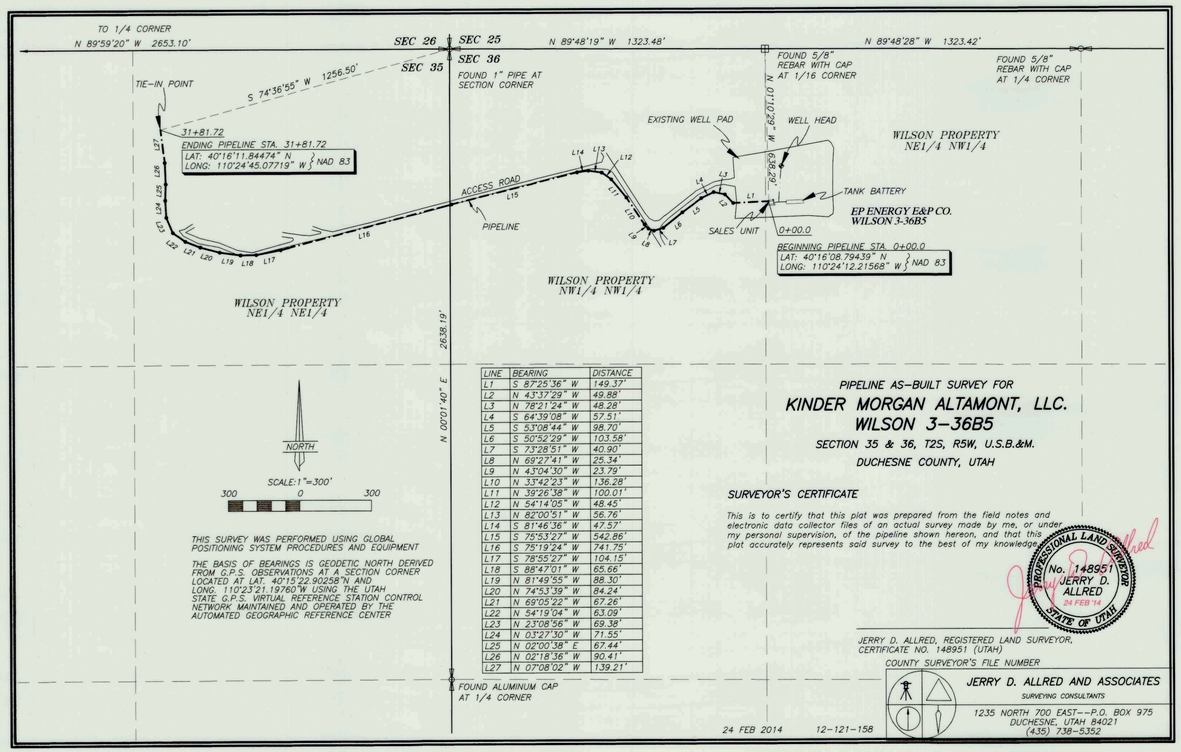

LINE	BEARING	DISTANCE
L1	S 87°25'36" W	149.37'
L2	N 43°37'29" W	49.88'
L3	N 78°21'24" W	48.28'
L4	S 64°39'08" W	57.51'
L6	S 50°52'29" W	103.58'
L7	S 73°28'51" W	40.90'
L8	N 69°27'41" W	25.34'
L9	N 43°04'30" W	23.79'
L10	N 33°42'23" W	136.28'
L11	N 39°26'38" W	100.01'
L12	N 54°14'05" W	48.45'
L13	N 82°00'51" W	56.76'
L14	S 81°46'36" W	47.57'
L15	S 75°53'27" W	542.86'
L16	S 75°19'24" W	741.75'
L17	S 78°55'27" W	104.15'
L18	S 88°47'01" W	65.66'
L19	N 81°49'55" W	88.30'
L20	N 74°53'39" W	84.24'
L21	N 69°05'22" W	67.26'
L22	N 54°19'04" W	63.09'
L24	N 03°27'30" W	71.55'
L25	N 02°00'38" E	67.44'
L26	N 02°18'36" W	90.41'
L27	N 07°08'02" W	139.21'

PIPELINE AS-BUILT SURVEY FOR

KINDER MORGAN ALTAMONT, LLC.

WILSON 3-36B5

SECTION 35 & 36, T2S, R5W, U.S.B.&M.

DUCHESNE COUNTY, UTAH

THIS SURVEY WAS PERFORMED USING GLOBAL POSITIONING SYSTEM PROCEDURES AND EQUIPMENT


SURVEYOR'S CERTIFICATE

This is to certify that this plat was prepared from the field notes and electronic data collector files of an actual survey made by me, or under my personal supervision, of the pipeline shown hereon, and that this plat accurately represents said survey to the best of my knowledge.

PROFESSIONAL LAND SURVEYOR No. 148951 JERRY D. ALLRED 24 FEB '14 STATE OF UTAH

JERRY D. ALLRED, REGISTERED LAND SURVEYOR, CERTIFICATE NO. 148951 (UTAH)

COUNTY SURVEYOR'S FILE NUMBER

JERRY D. ALLRED AND ASSOCIATES
SURVEYING CONSULTANTS
1235 NORTH 700 EAST--P.O. BOX 975
DUCHESNE, UTAH 84021
(435) 738-5352

24 FEB 2014 12-121-158

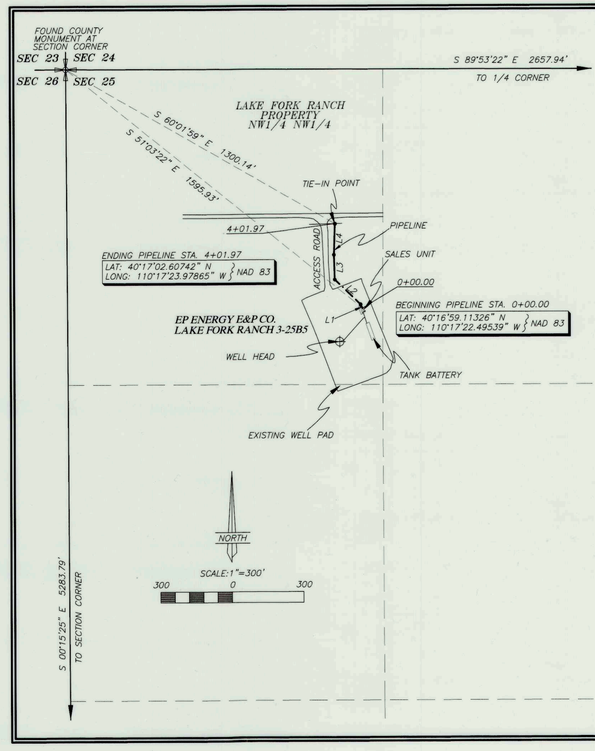

LINE	BEARING	DISTANCE
L1	N 26°15'36" W	18.65'
L2	N 46°15'33" W	149.63'
L3	N 01°53'14" W	103.22'
L4	N 02°07'03" E	130.47'

THIS SURVEY WAS PERFORMED USING GLOBAL POSITIONING SYSTEM PROCEDURES AND EQUIPMENT

THE BASIS OF BEARINGS IS GEODETIC NORTH DERIVED FROM G.P.S. OBSERVATIONS AT A SECTION CORNER LOCATED AT LAT. 40°21'13.56882"N AND LONG. 110°16'31.53266"W USING THE UTAH STATE G.P.S. VIRTUAL REFERENCE STATION CONTROL NETWORK MAINTAINED AND OPERATED BY THE AUTOMATED GEOGRAPHIC REFERENCE CENTER

SURVEYOR'S CERTIFICATE

This is to certify that this plat was prepared from the field notes and electronic data collector files of an actual survey made by me, or under my personal supervision, of the pipeline shown hereon, and that this plat accurately represents said survey to the best of my knowledge.

PROFESSIONAL LAND SURVEYOR No. 148951 JERRY D. ALLRED 10 FEB '14 STATE OF UTAH

JERRY D. ALLRED, REGISTERED LAND SURVEYOR, CERTIFICATE NO. 148951 (UTAH)

COUNTY SURVEYOR'S FILE NUMBER

JERRY D. ALLRED AND ASSOCIATES
SURVEYING CONSULTANTS
1235 NORTH 700 EAST--P.O. BOX 975
DUCHESNE, UTAH 84021
(435) 738-5352

10 FEB 2014 12-121-159

County Surveyors File # 2945