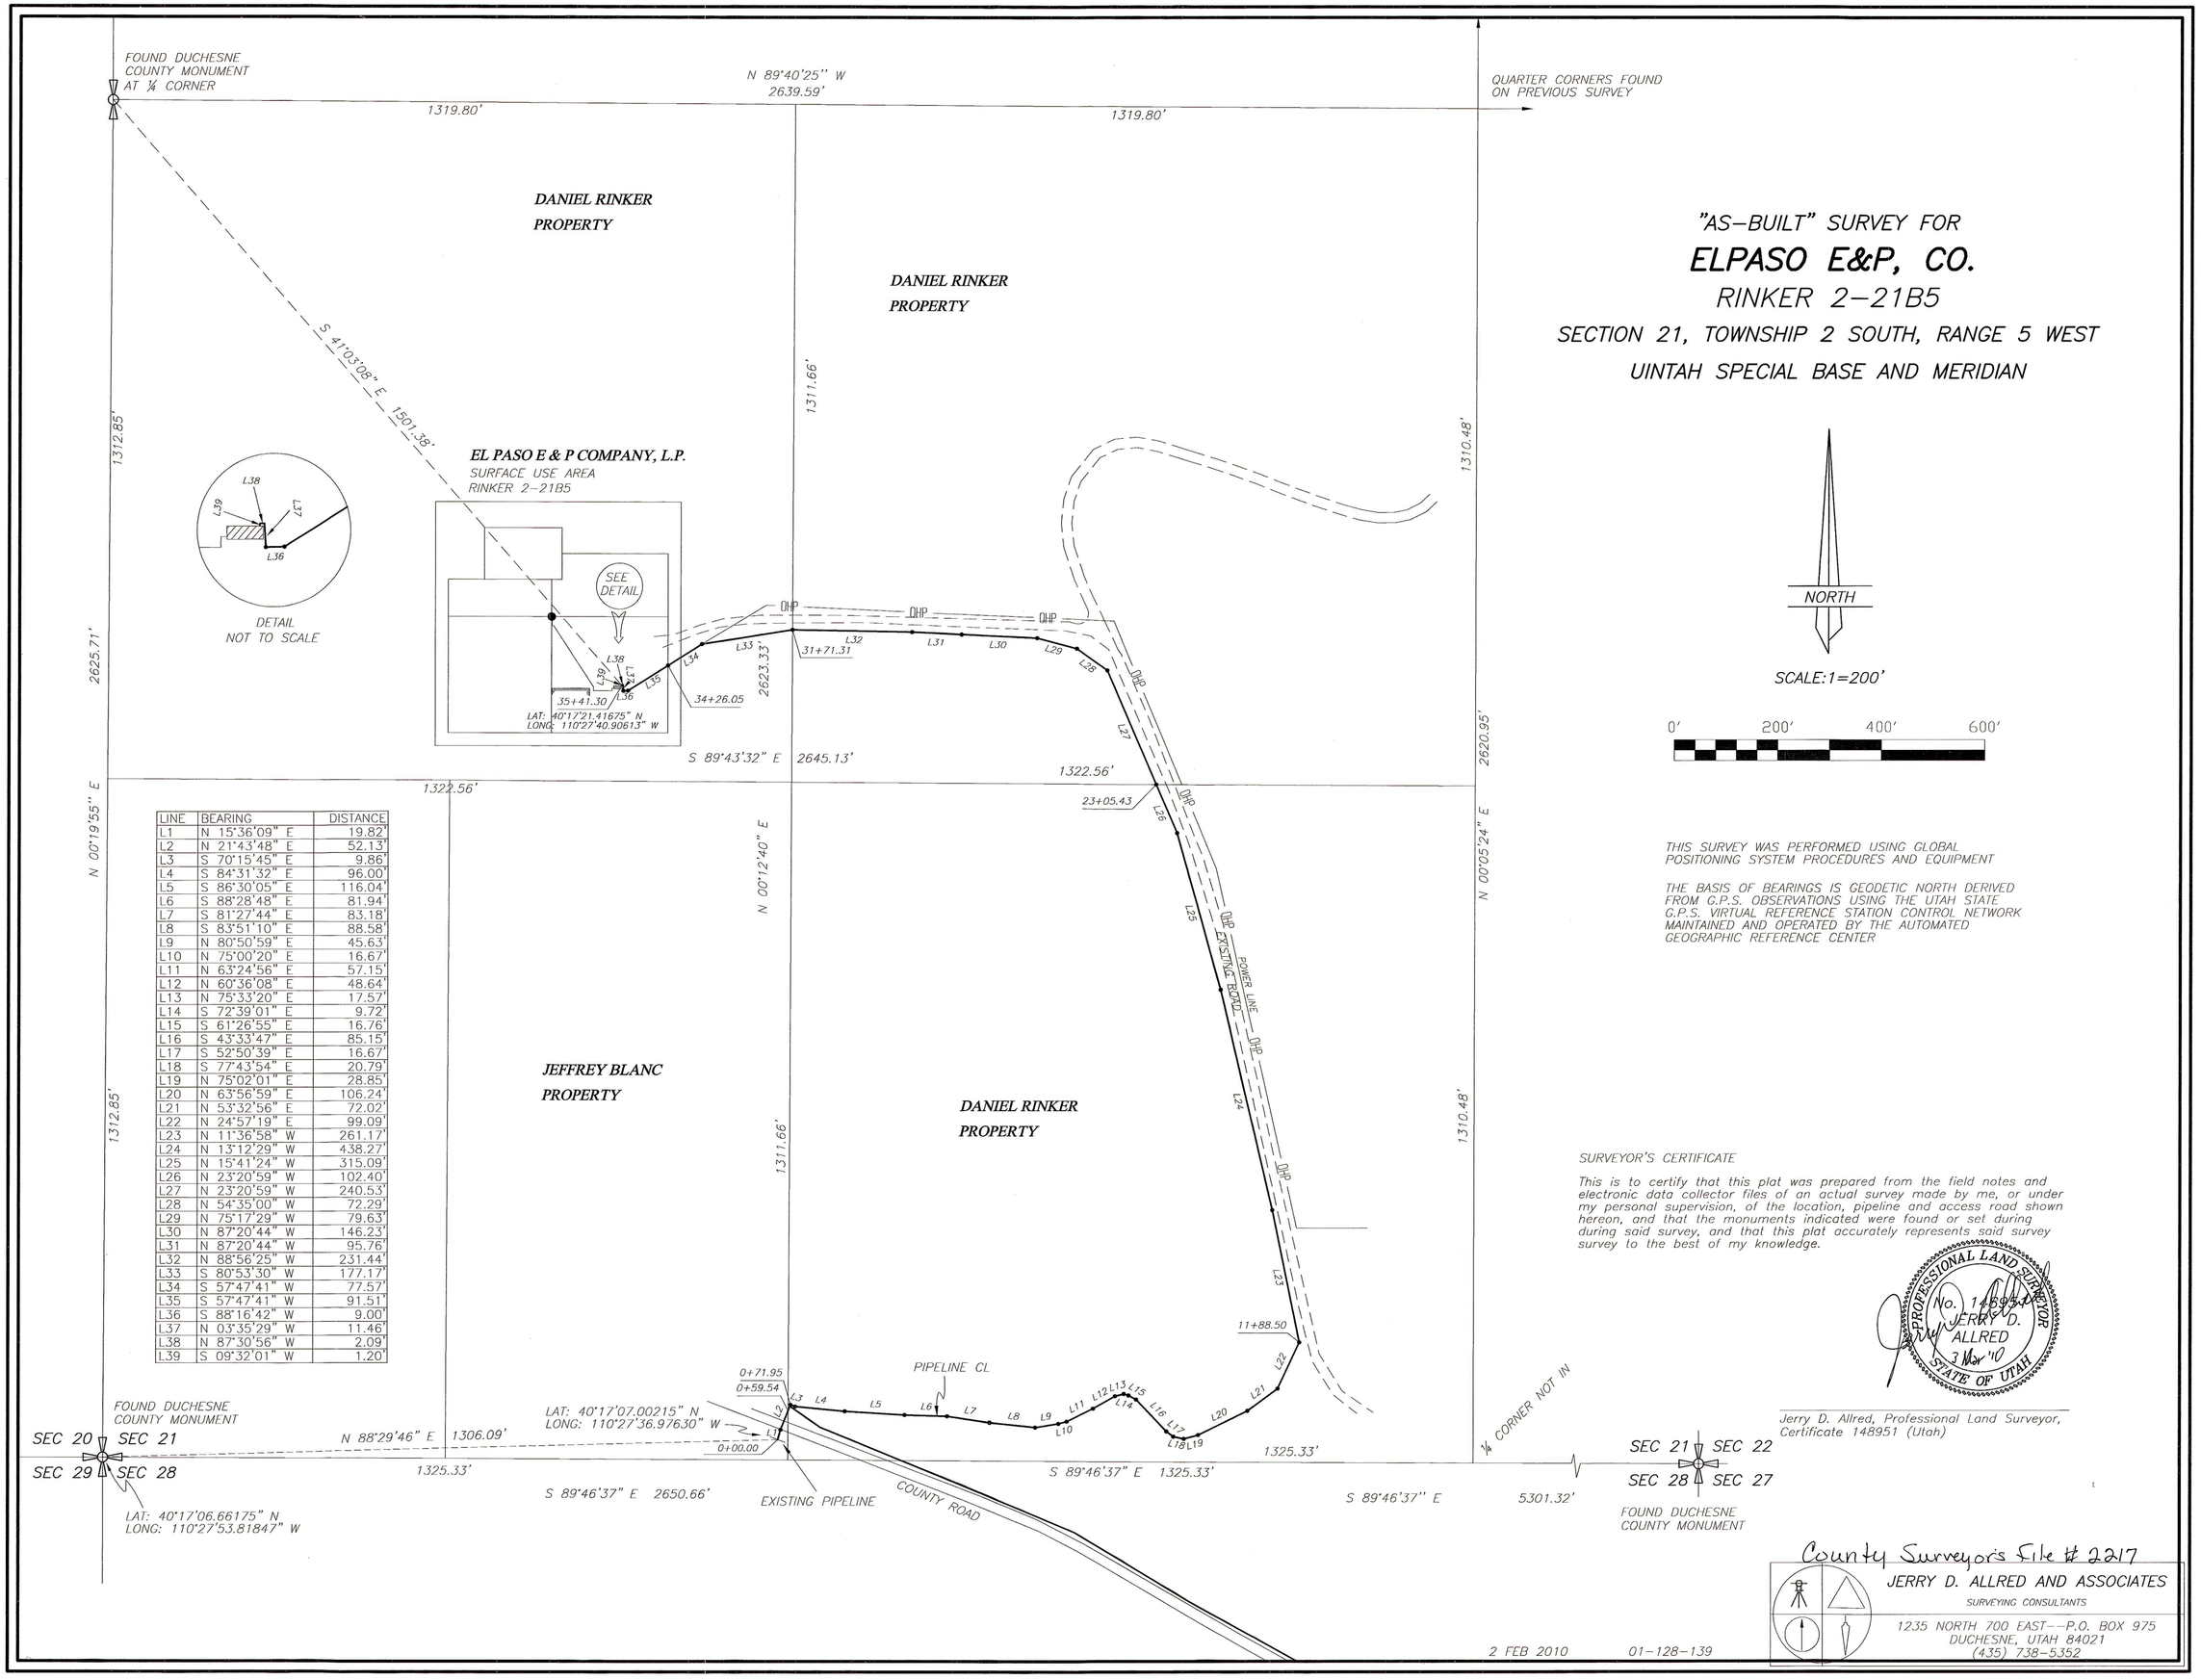

LINE	BEARING	DISTANCE
L1	N 15°36'09" E	19.82'
L2	N 21°43'48" E	52.13'
L3	S 70°15'45" E	9.86'
L4	S 84°31'32" E	96.00'
L5	S 86°30'05" E	116.04'
L6	S 88°28'48" E	81.94'
L7	S 81°27'44" E	83.18'
L8	S 83°51'10" E	88.58'
L9	N 80°50'59" E	45.63'
L10	N 75°00'20" E	16.67'
L11	N 63°24'56" E	57.15'
L12	N 60°36'08" E	48.64'
L13	N 75°33'20" E	17.57'
L14	S 72°39'01" E	9.72'
L15	S 61°26'55" E	16.76'
L16	S 43°33'47" E	85.15'
L17	S 52°50'39" E	16.67'
L18	S 77°43'54" E	20.79'
L19	N 75°02'01" E	28.85'
L20	N 63°56'59" E	106.24'
L21	N 53°32'56" E	72.02'
L22	N 24°57'19" E	99.09'
L23	N 11°36'58" W	261.17'
L24	N 13°12'29" W	438.27'
L25	N 15°41'24" W	315.09'
L26	N 23°20'59" W	102.40'
L27	N 23°20'59" W	240.53'
L28	N 54°35'00" W	72.29'
L29	N 75°17'29" W	79.63'
L30	N 87°20'44" W	146.23'
L31	N 87°20'44" W	95.76'
L32	N 88°56'25" W	231.44'
L33	S 80°53'30" W	177.17'
L34	S 57°47'41" W	77.57'
L35	S 57°47'41" W	91.51'
L36	S 88°16'42" W	9.00'
L37	N 03°35'29" W	11.46'
L38	N 87°30'56" W	2.09'
L39	S 09°32'01" W	1.20'

"AS-BUILT" SURVEY FOR

ELPASO E&P, CO.

RINKER 2-21B5

SECTION 21, TOWNSHIP 2 SOUTH, RANGE 5 WEST

UINTAH SPECIAL BASE AND MERIDIAN

NORTH

SCALE:1=200'

0' 200' 400' 600'

THIS SURVEY WAS PERFORMED USING GLOBAL POSITIONING SYSTEM PROCEDURES AND EQUIPMENT

THE BASIS OF BEARINGS IS GEODETIC NORTH DERIVED FROM G.P.S. OBSERVATIONS USING THE UTAH STATE G.P.S. VIRTUAL REFERENCE STATION CONTROL NETWORK MAINTAINED AND OPERATED BY THE AUTOMATED GEOGRAPHIC REFERENCE CENTER

SURVEYOR'S CERTIFICATE

This is to certify that this plat was prepared from the field notes and electronic data collector files of an actual survey made by me, or under my personal supervision, of the location, pipeline and access road shown hereon, and that the monuments indicated were found or set during during said survey, and that this plat accurately represents said survey survey to the best of my knowledge.

PROFESSIONAL LAND SURVEYOR No. 148951 JERRY D. ALLRED 3 Mar '10 STATE OF UTAH

Jerry D. Allred, Professional Land Surveyor, Certificate 148951 (Utah)

County Surveyor's File # 2217

JERRY D. ALLRED AND ASSOCIATES

SURVEYING CONSULTANTS

1235 NORTH 700 EAST--P.O. BOX 975
DUCHESNE, UTAH 84021
(435) 738-5352

2 FEB 2010 01-128-139