AS-BUILT SURVEY FOR
ELPASO E&P, CO.
SECTIONS 18, 19, 20, AND 21,
TOWNSHIP 3 SOUTH, RANGE 6 WEST
UINTAH SPECIAL BASE AND MERIDIAN

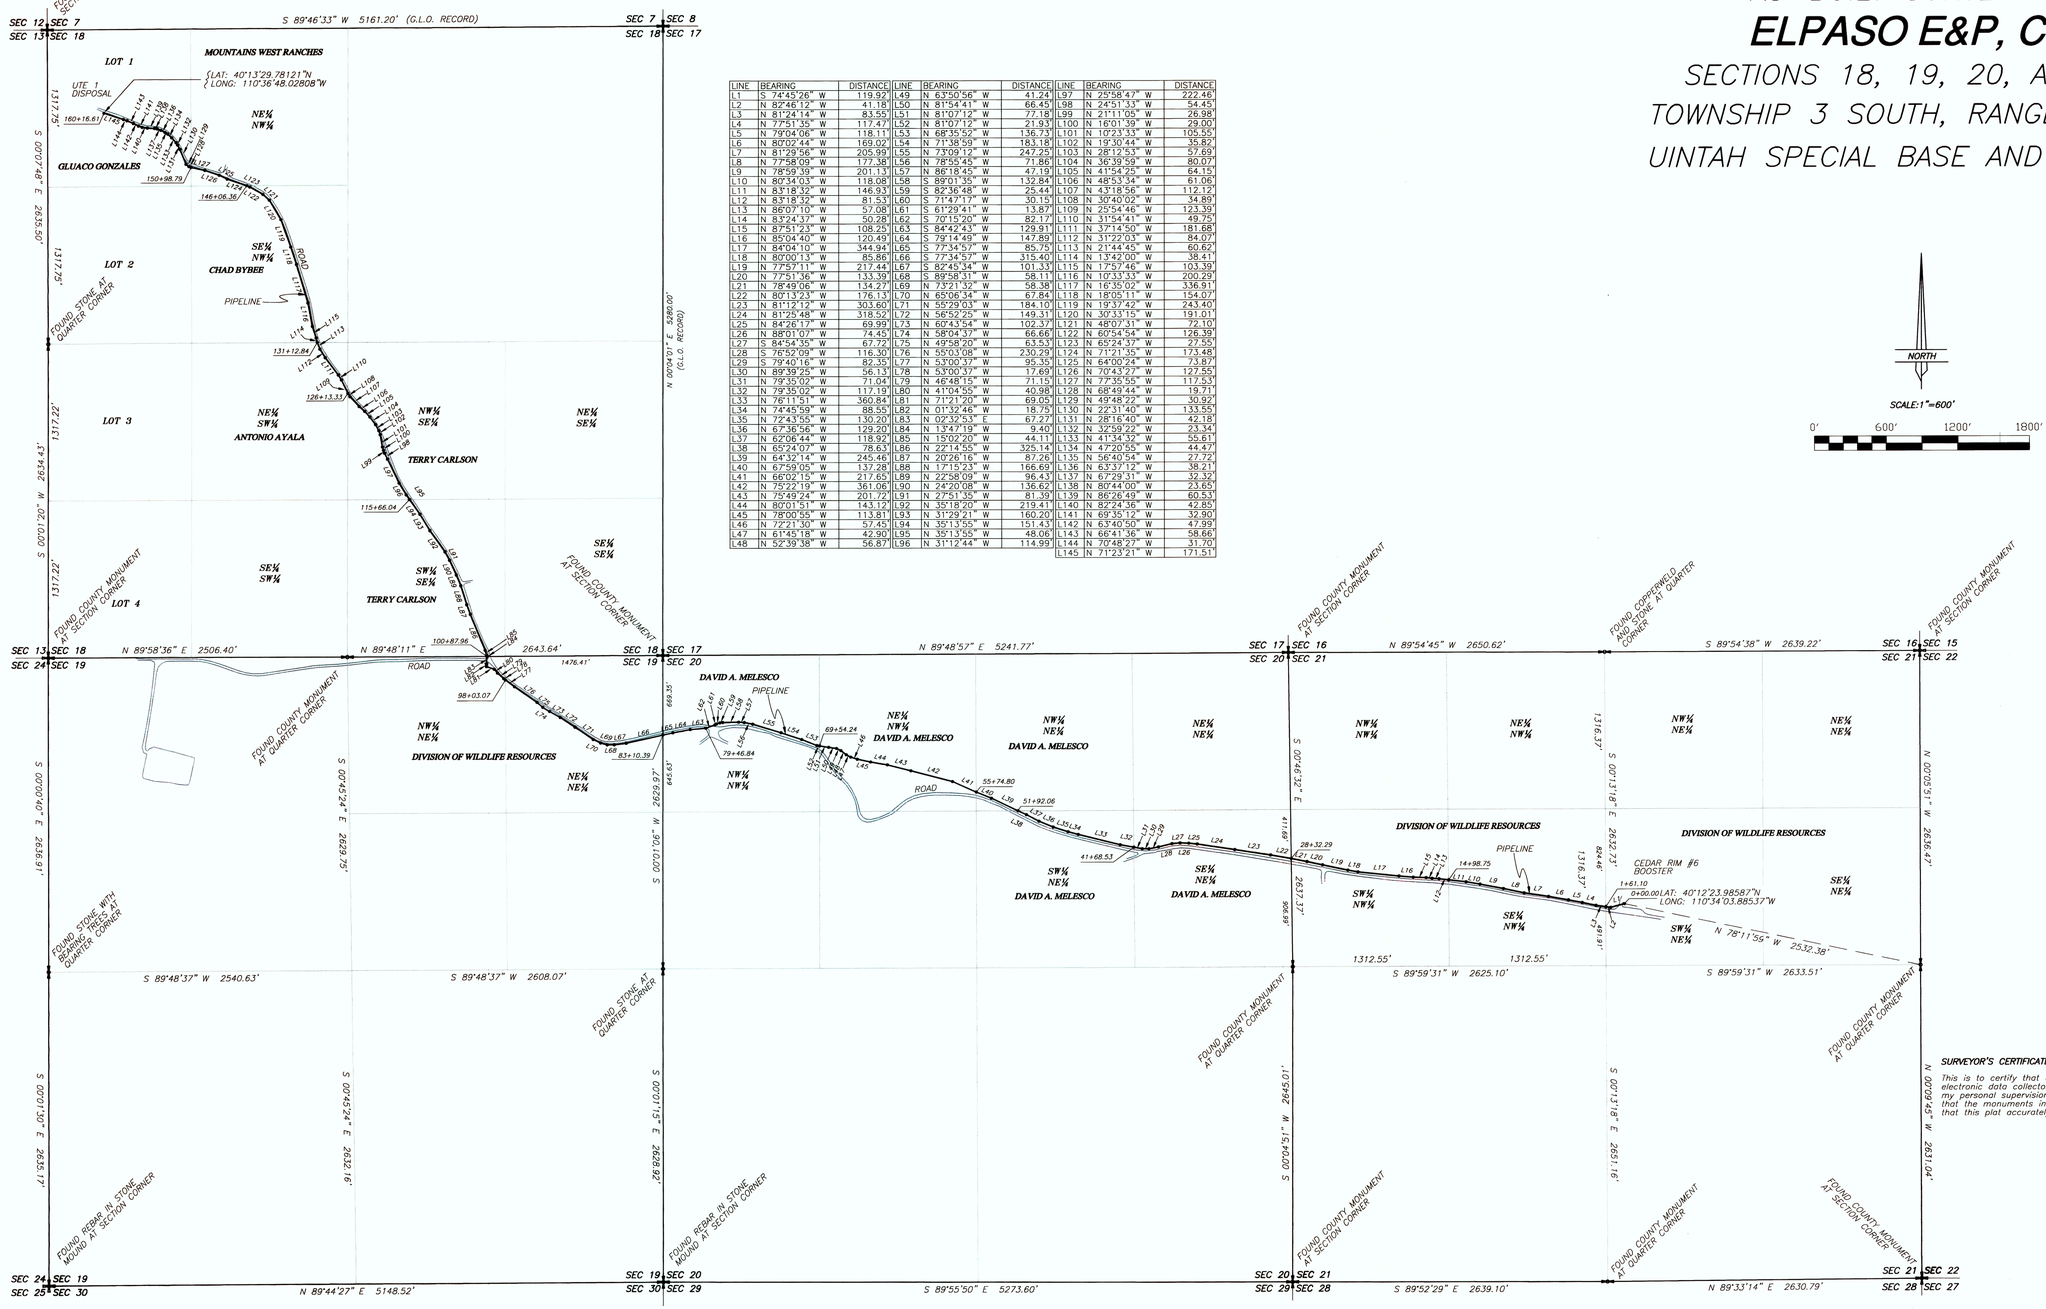

LINE	BEARING	DISTANCE
L1	S 74°45'26" W	119.92'
L2	N 82°46'12" W	41.18'
L3	N 81°24'14" W	83.55'
L4	N 77°51'35" W	117.47'
L5	N 79°04'06" W	118.11'
L6	N 80°02'44" W	169.02'
L7	N 81°29'56" W	205.99'
L8	N 77°58'09" W	177.38'
L9	N 78°59'39" W	201.13'
L10	N 80°34'03" W	118.08'
L11	N 83°18'32" W	146.93'
L12	N 83°18'32" W	81.53'
L13	N 86°07'10" W	57.08'
L14	N 83°24'37" W	50.28'
L15	N 87°51'23" W	108.25'
L16	N 85°04'40" W	120.49'
L17	N 84°04'10" W	344.94'
L18	N 80°00'13" W	85.86'
L19	N 77°57'11" W	217.44'
L20	N 77°51'36" W	133.39'
L21	N 78°49'06" W	134.27'
L22	N 80°13'23" W	176.13'
L23	N 81°12'12" W	303.60'
L24	N 81°25'48" W	318.52'
L25	N 84°26'17" W	69.99'
L26	N 88°01'07" W	74.45'
L27	S 84°54'35" W	67.72'
L28	S 76°52'09" W	116.30'
L29	S 79°40'16" W	82.35'
L30	N 89°39'25" W	56.13'
L31	N 79°35'02" W	71.04'
L32	N 79°35'02" W	117.19'
L33	N 76°11'51" W	360.84'
L34	N 74°45'59" W	88.55'
L35	N 72°43'55" W	130.20'
L36	N 67°36'56" W	129.20'
L37	N 62°06'44" W	118.92'
L38	N 62°24'07" W	78.63'
L39	N 64°32'14" W	245.46'
L40	N 67°59'05" W	137.28'
L41	N 66°02'15" W	217.65'
L42	N 75°22'19" W	361.06'
L43	N 75°49'24" W	201.72'
L44	N 80°01'51" W	143.12'
L45	N 78°00'55" W	113.81'
L46	N 72°21'30" W	57.45'
L47	N 61°45'18" W	42.90'
L48	N 52°39'38" W	56.87'
L49	N 63°50'56" W	41.24'
L50	N 81°54'41" W	66.45'
L51	N 81°07'12" W	77.18'
L52	N 81°07'12" W	21.93'
L53	N 68°35'52" W	136.73'
L54	N 71°38'59" W	183.18'
L55	N 73°09'12" W	247.25'
L56	N 78°55'45" W	71.86'
L57	N 86°18'45" W	47.19'
L58	S 89°01'35" W	132.84'
L59	S 82°36'48" W	25.44'
L60	S 71°47'17" W	30.15'
L61	S 61°29'41" W	13.87'
L62	S 70°15'20" W	82.17'
L63	S 84°42'43" W	129.91'
L64	S 79°14'49" W	147.89'
L65	S 77°34'57" W	85.75'
L66	S 77°34'57" W	315.40'
L67	S 82°45'34" W	101.33'
L68	S 89°58'31" W	58.11'
L69	N 73°21'32" W	58.38'
L70	N 65°06'34" W	67.84'
L71	N 55°29'03" W	184.10'
L72	N 56°52'25" W	149.31'
L73	N 60°43'54" W	102.37'
L74	N 58°04'37" W	66.66'
L75	N 49°58'20" W	63.53'
L76	N 55°03'08" W	230.29'
L77	N 53°00'37" W	95.35'
L78	N 53°00'37" W	17.69'
L79	N 46°48'15" W	71.15'
L80	N 41°04'55" W	40.98'
L81	N 71°21'20" W	69.05'
L82	N 01°32'46" W	18.75'
L83	N 02°32'53" E	67.27'
L84	N 13°47'19" W	9.40'
L85	N 15°02'20" W	44.11'
L86	N 22°14'55" W	325.14'
L87	N 20°26'16" W	87.26'
L88	N 17°15'23" W	166.69'
L89	N 22°56'09" W	96.43'
L90	N 24°20'08" W	136.62'
L91	N 27°51'35" W	81.39'
L92	N 35°18'20" W	219.41'
L93	N 31°29'21" W	160.20'
L94	N 35°13'55" W	151.43'
L95	N 35°13'55" W	48.06'
L96	N 31°12'44" W	114.99'
L97	N 25°58'47" W	222.46'
L98	N 24°51'33" W	54.45'
L99	N 21°11'05" W	26.98'
L100	N 16°01'39" W	29.00'
L101	N 10°23'33" W	105.55'
L102	N 19°30'44" W	35.82'
L103	N 28°12'53" W	57.69'
L104	N 36°39'59" W	80.07'
L105	N 41°54'25" W	64.15'
L106	N 48°53'34" W	61.06'
L107	N 43°18'56" W	112.12'
L108	N 30°40'02" W	34.89'
L109	N 25°54'46" W	123.39'
L110	N 31°54'41" W	49.75'
L111	N 37°14'50" W	181.68'
L112	N 31°22'03" W	84.07'
L113	N 21°44'45" W	60.62'
L114	N 13°42'00" W	38.41'
L115	N 17°57'46" W	103.39'
L116	N 10°33'33" W	200.29'
L117	N 16°35'02" W	336.91'
L118	N 18°05'11" W	154.07'
L119	N 19°37'42" W	243.40'
L120	N 30°33'15" W	191.01'
L121	N 48°07'31" W	72.10'
L122	N 60°54'54" W	126.39'
L123	N 65°24'37" W	27.55'
L124	N 71°21'35" W	173.48'
L125	N 64°00'24" W	73.87'
L126	N 70°43'27" W	127.55'
L127	N 77°35'55" W	117.53'
L128	N 68°49'44" W	19.71'
L129	N 49°48'22" W	30.92'
L130	N 22°31'40" W	133.55'
L131	N 28°16'40" W	42.18'
L132	N 32°59'22" W	23.34'
L133	N 41°34'32" W	55.61'
L134	N 47°20'55" W	44.47'
L135	N 56°40'54" W	27.72'
L136	N 63°37'12" W	38.21'
L137	N 67°29'31" W	32.32'
L138	N 80°44'00" W	23.65'
L139	N 86°26'49" W	60.53'
L140	N 82°24'36" W	42.85'
L141	N 69°35'12" W	32.90'
L142	N 63°40'50" W	47.99'
L143	N 66°41'36" W	58.66'
L144	N 70°48'27" W	31.70'
L145	N 71°23'21" W	171.51'

SURVEYOR'S CERTIFICATE

This is to certify that this plat was prepared from the field notes and electronic data collector files of an actual survey made by me, or under my personal supervision of the pipeline right-of-way shown hereon, and that the monuments indicated were found or set during said survey, and that this plat accurately represents said survey to the best of my knowledge.

PROFESSIONAL LAND SURVEYOR No. 148951 JERRY D. ALLRED 7 JAN 11 STATE OF UTAH

JERRY D. ALLRED, REGISTERED LAND SURVEYOR, CERTIFICATE NO. 148951 (UTAH)

County Surveyors File # 2368

JERRY D. ALLRED & ASSOCIATES
SURVEYING CONSULTANTS
1235 NORTH 700 EAST--P.O. BOX 975
DUCHESNE, UTAH 84021
(435) 738-5352

7 JAN 2011 01-128-209