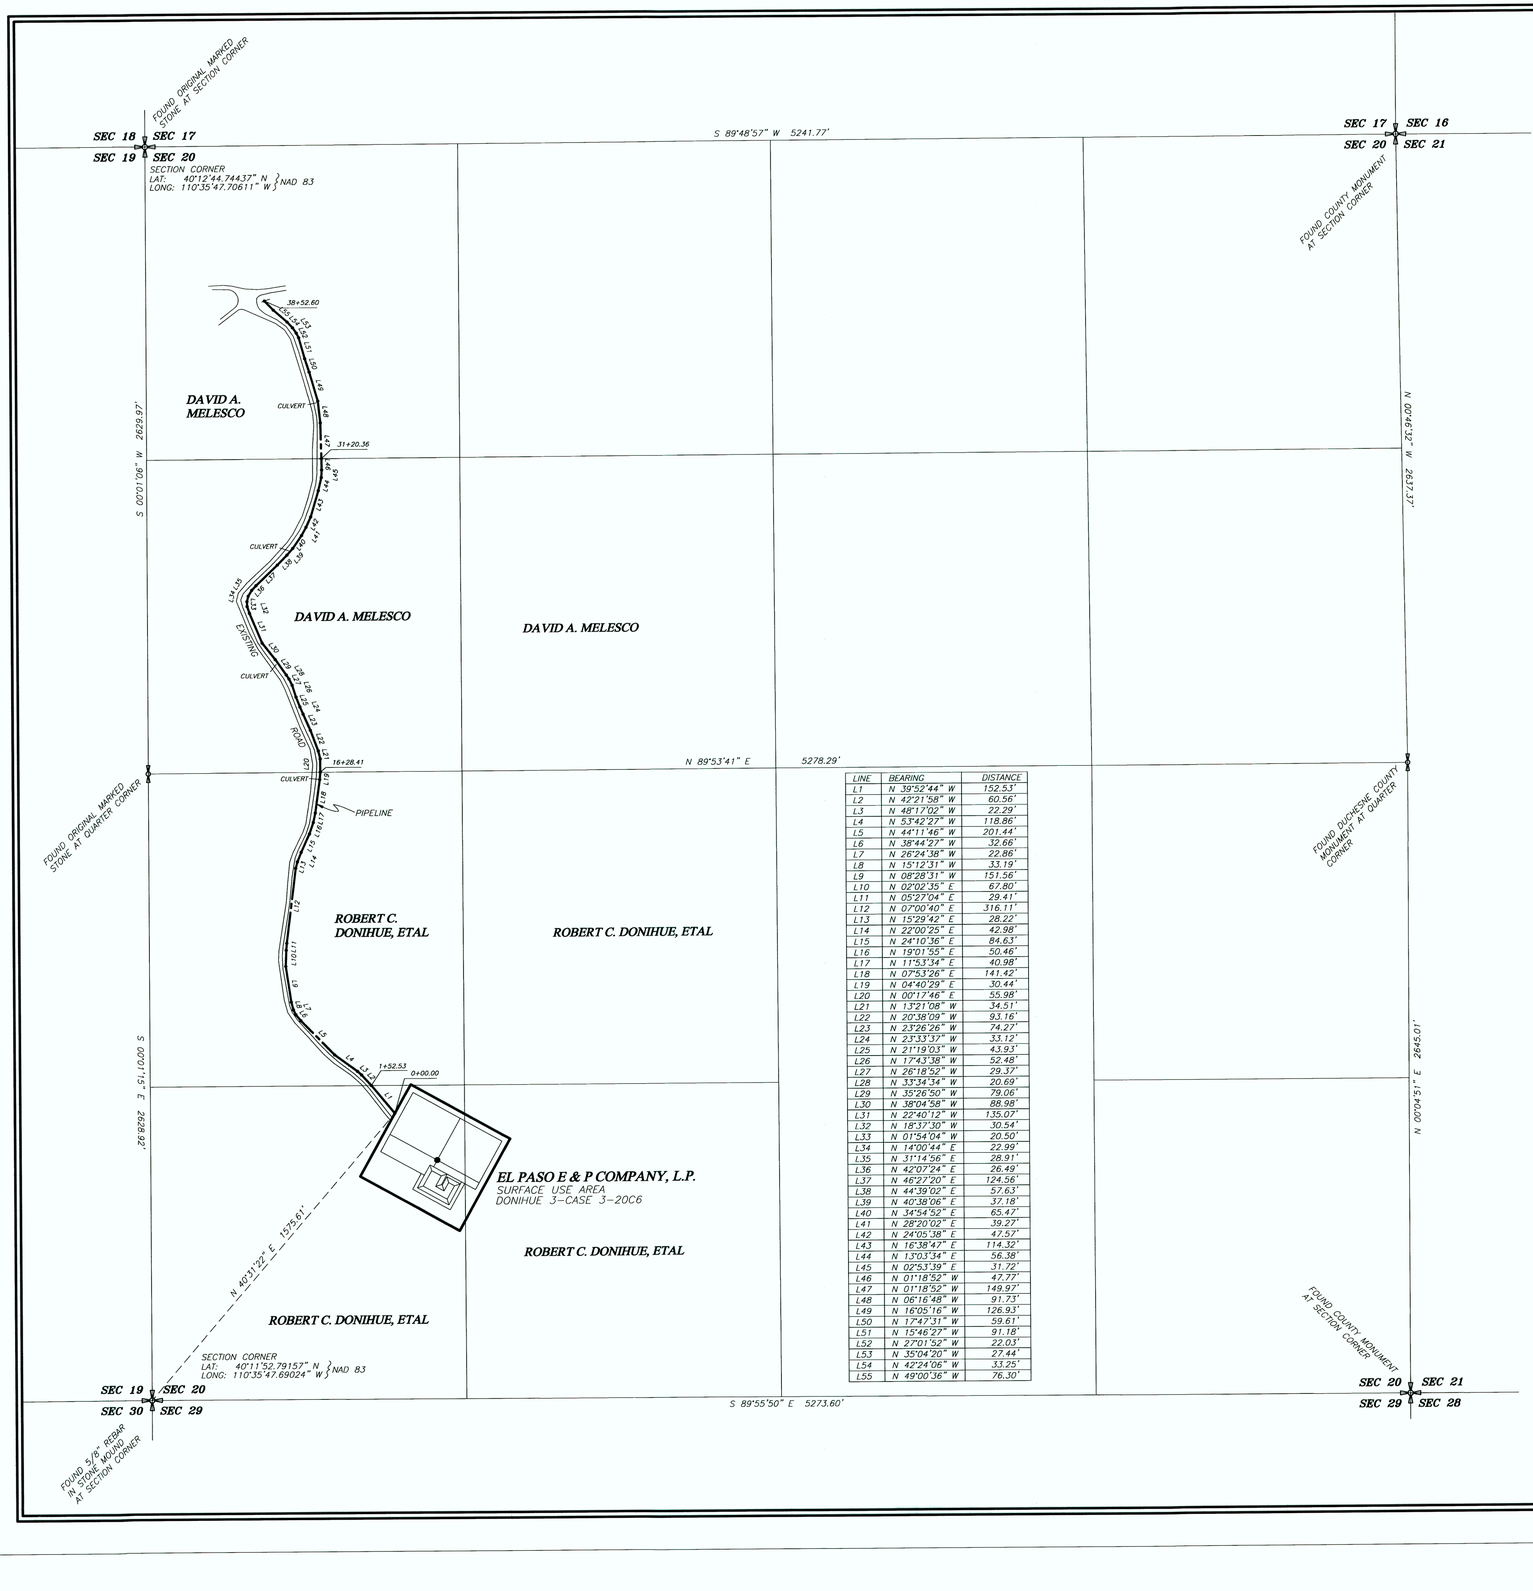


| LINE | BEARING | DISTANCE |
|---|---|---|
| L1 | N 39°52'44" W | 152.53' |
| L2 | N 42°21'58" W | 60.56' |
| L3 | N 48°17'02" W | 22.29' |
| L4 | N 53°42'27" W | 118.86' |
| L5 | N 44°11'46" W | 201.44' |
| L6 | N 38°44'27" W | 32.66' |
| L7 | N 26°24'38" W | 22.86' |
| L8 | N 15°12'31" W | 33.19' |
| L9 | N 08°28'31" W | 151.56' |
| L10 | N 02°02'35" E | 67.80' |
| L11 | N 05°27'04" E | 29.41' |
| L12 | N 07°00'40" E | 316.11' |
| L13 | N 15°29'42" E | 28.22' |
| L14 | N 22°00'25" E | 42.98' |
| L15 | N 24°10'36" E | 84.63' |
| L16 | N 19°01'55" E | 50.46' |
| L17 | N 11°53'34" E | 40.98' |
| L18 | N 07°53'26" E | 141.42' |
| L19 | N 04°40'29" E | 30.44' |
| L20 | N 00°17'46" E | 55.98' |
| L21 | N 13°21'08" W | 34.51' |
| L22 | N 20°38'09" W | 93.16' |
| L23 | N 23°26'26" W | 74.27' |
| L24 | N 23°33'37" W | 33.12' |
| L25 | N 21°19'03" W | 43.93' |
| L26 | N 17°43'38" W | 52.48' |
| L27 | N 26°18'52" W | 29.37' |
| L28 | N 33°34'34" W | 20.69' |
| L29 | N 35°26'50" W | 79.06' |
| L30 | N 38°04'58" W | 88.98' |
| L31 | N 22°40'12" W | 135.07' |
| L32 | N 18°37'30" W | 30.54' |
| L33 | N 01°54'04" W | 20.50' |
| L34 | N 14°00'44" E | 22.99' |
| L35 | N 31°14'56" E | 28.91' |
| L36 | N 42°07'24" E | 26.49' |
| L37 | N 46°27'20" E | 124.56' |
| L38 | N 44°39'02" E | 57.63' |
| L39 | N 40°38'06" E | 37.18' |
| L40 | N 34°54'52" E | 65.47' |
| L41 | N 28°20'02" E | 39.27' |
| L42 | N 24°05'38" E | 47.57' |
| L43 | N 16°38'47" E | 114.32' |
| L44 | N 13°03'34" E | 56.38' |
| L45 | N 02°53'39" E | 31.72' |
| L47 | N 01°18'52" W | 149.97' |
| L48 | N 06°16'48" W | 91.73' |
| L49 | N 16°05'16" W | 126.93' |
| L50 | N 17°47'31" W | 59.61' |
| L51 | N 15°46'27" W | 91.18' |
| L52 | N 27°01'52" W | 22.03' |
| L53 | N 35°04'20" W | 27.44' |
| L54 | N 42°24'06" W | 33.25' |
| L55 | N 49°00'36" W | 76.30' |

"AS-BUILT" PIPELINE SURVEY FOR

# EL PASO E & P COMPANY, L.P.

DONIHUE 3-20C6

SECTION 20, TOWNSHIP 3 SOUTH, RANGE 6 WEST

UINTAH SPECIAL BASE AND MERIDIAN

NORTH

SCALE: 1"=300'

0' 300' 600' 900'

THIS SURVEY WAS PERFORMED USING G.P.S. (GLOBAL POSITIONING SYSTEM) PROCEDURES AND EQUIPMENT. THE BASIS OF BEARINGS IS BASED ON WGS-84 DATUM.

## SURVEYOR'S CERTIFICATE

This is to certify that this plat was prepared from the field notes and electronic data collector files of an actual survey made by me, or under my personal supervision, of the use area right-of-way shown hereon, and that the monuments indicated were found or set during said survey, and that this plat accurately represents said survey to the best of my knowledge.

PROFESSIONAL LAND SURVEYOR No. 148951 JERRY D. ALLRED 12 SEP 11 STATE OF UTAH

Jerry D. Allred, Professional Land Surveyor, Certificate 148951 (Utah)

Duchesne County Surveyor's File # 2474

JERRY D. ALLRED & ASSOCIATES
SURVEYING CONSULTANTS
1235 NORTH 700 EAST--P.O. BOX 975
DUCHESNE, UTAH 84021
(435) 738-5352

9 SEP 2011 01-128-195