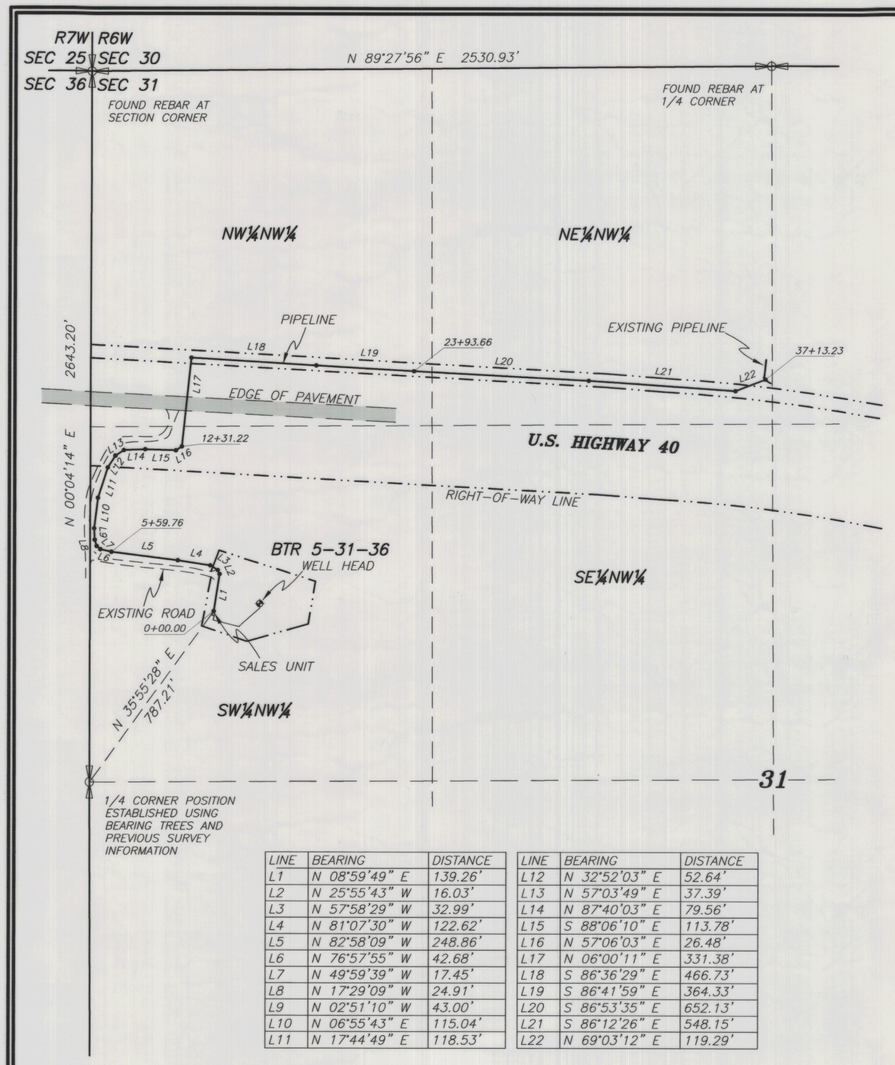

LINE	BEARING	DISTANCE
L1	N 08°59'49" E	139.26'
L2	N 25°55'43" W	16.03'
L3	N 57°58'29" W	32.99'
L4	N 81°07'30" W	122.62'
L5	N 82°58'09" W	248.86'
L6	N 76°57'55" W	42.68'
L7	N 49°59'39" W	17.45'
L8	N 17°29'09" W	24.91'
L9	N 02°51'10" W	43.00'
L10	N 06°55'43" E	115.04'
L11	N 17°44'49" E	118.53'

LINE	BEARING	DISTANCE
L12	N 32°52'03" E	52.64'
L13	N 57°03'49" E	37.39'
L14	N 87°40'03" E	79.56'
L15	S 88°06'10" E	113.78'
L16	N 57°06'03" E	26.48'
L17	N 06°00'11" E	331.38'
L18	S 86°36'29" E	466.73'
L19	S 86°41'59" E	364.33'
L20	S 86°53'35" E	652.13'
L21	S 86°12'26" E	548.15'
L22	N 69°03'12" E	119.29'

PIPELINE "AS-BUILT" SURVEY FOR

KINDER MORGAN ALTAMONT, LLC.

BTR 5-31-36

SECTION 31, T3S, R6W, U.S.B.&M.

DUCHESNE COUNTY, UTAH

NORTH

SCALE:1"=400'

0' 400' 800'

SURVEYOR'S CERTIFICATE

This is to certify that this plat was prepared from the field notes and electronic data collector files of an actual survey made by me, or under my personal supervision, of the location of the pipeline shown hereon, and that the monuments indicated were found or set during said survey, and that this plat accurately represents said survey to the best of my knowledge.

PROFESSIONAL LAND SURVEYOR
No. 148951
JERRY D. ALLRED
3 MAY '13
STATE OF UTAH

Jerry D. Allred, Professional Land Surveyor, Certificate 148951 (Utah)

THIS SURVEY WAS PERFORMED USING GLOBAL POSITIONING SYSTEM PROCEDURES AND EQUIPMENT

THE BASIS OF BEARINGS IS GEODETIC NORTH DERIVED FROM G.P.S. OBSERVATIONS AT THE SECTION CORNER LOCATED AT LAT. 40°15'22.90258"N AND LONG. 110°23'21.19760"W USING THE UTAH STATE G.P.S. VIRTUAL REFERENCE STATION CONTROL NETWORK MAINTAINED AND OPERATED BY THE AUTOMATED GEOGRAPHIC REFERENCE CENTER

3 MAY 2013 12-121-020

County Surveyor File # 2750

JERRY D. ALLRED AND ASSOCIATES
SURVEYING CONSULTANTS
1235 NORTH 700 EAST--P.O. BOX 975
DUCHESNE, UTAH 84021
(435) 738-5352