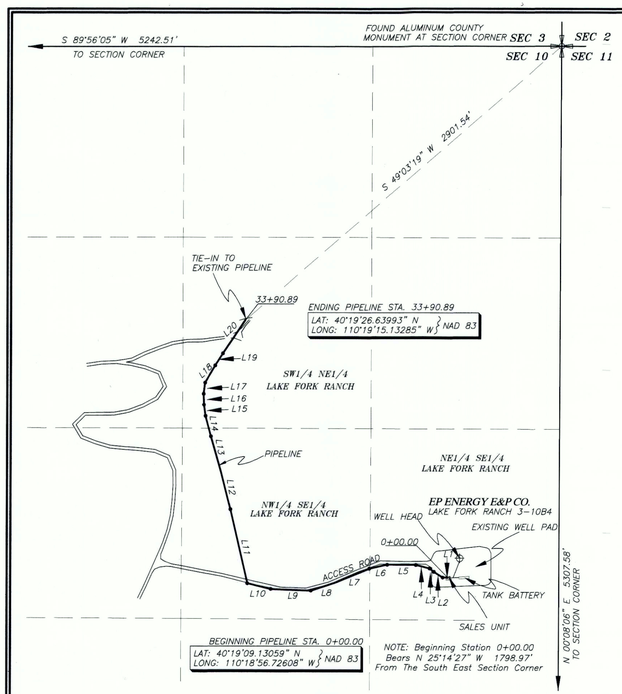

PIPELINE AS-BUILT SURVEY FOR

KINDER MORGAN ALTAMONT, LLC.

LAKE FORK RANCH 3-10B4

SECTION 10, T2S, R4W, U.S.B.&M.

DUCHESNE COUNTY, UTAH

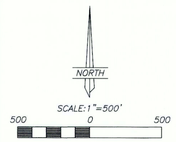

LINE	BEARING	DISTANCE
L1	S 89°00'53" W	35.96'
L2	N 56°58'01" W	71.73'
L3	N 52°49'30" W	37.73'
L4	N 75°44'01" W	98.84'
L5	N 89°35'39" W	197.34'
L6	S 77°44'12" W	127.59'
L7	S 67°35'48" W	244.40'
L8	S 71°24'58" W	189.36'
L9	N 87°32'03" W	279.73'
L10	N 76°25'10" W	167.40'
L11	N 13°02'37" W	526.60'
L12	N 14°10'53" W	270.52'
L13	N 16°11'23" W	252.85'
L14	N 15°05'11" W	146.59'
L15	N 07°51'54" W	77.82'
L16	N 01°53'06" W	75.85'
L17	N 07°04'55" E	78.44'
L18	N 30°30'42" E	138.03'
L19	N 32°38'13" E	98.87'
L20	N 33°52'24" E	275.24'

THIS SURVEY WAS PERFORMED USING GLOBAL POSITIONING SYSTEM PROCEDURES AND EQUIPMENT

THE BASIS OF BEARINGS IS GEODETIC NORTH DERIVED FROM G.P.S. OBSERVATIONS AT A SECTION CORNER LOCATED AT LAT. 40°21'33.56882"N AND LONG. 110°16'31.53266"W USING THE UTAH STATE G.P.S. VIRTUAL REFERENCE STATION CONTROL NETWORK MAINTAINED AND OPERATED BY THE AUTOMATED GEOGRAPHIC REFERENCE CENTER

SURVEYOR'S CERTIFICATE

This is to certify that this plat was prepared from the field notes and electronic data collector files of an actual survey made by me, or under my personal supervision, of the pipeline shown hereon, and that this plat accurately represents said survey to the best of my knowledge.

PROFESSIONAL LAND SURVEYOR No. 148951 JERRY D. ALLRED 8 JAN '14 STATE OF UTAH

JERRY D. ALLRED, REGISTERED LAND SURVEYOR, CERTIFICATE NO. 148951 (UTAH)

COUNTY SURVEYOR'S FILE NUMBER

JERRY D. ALLRED AND ASSOCIATES
SURVEYING CONSULTANTS
1235 NORTH 700 EAST--P.O. BOX 975
DUCHESNE, UTAH 84021
(435) 738-5352

8 JAN 2014 12-121-111

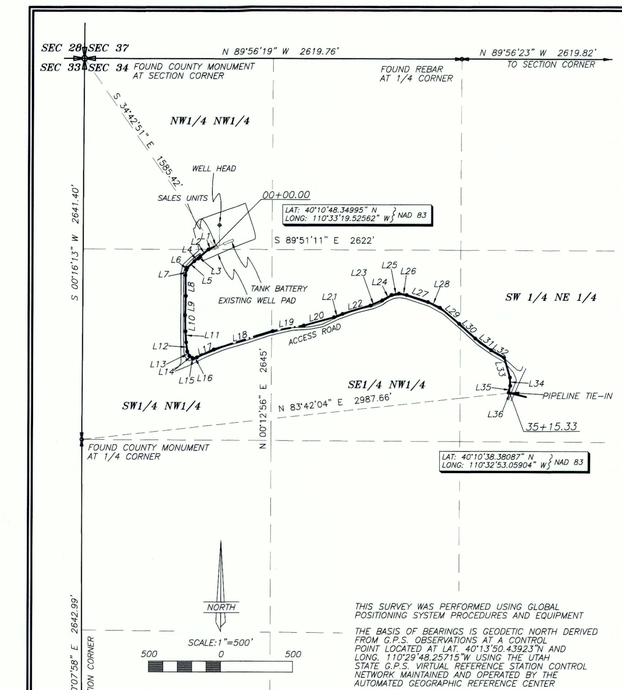

THIS SURVEY WAS PERFORMED USING GLOBAL POSITIONING SYSTEM PROCEDURES AND EQUIPMENT

THE BASIS OF BEARINGS IS GEODETIC NORTH DERIVED FROM G.P.S. OBSERVATIONS AT A CONTROL POINT LOCATED AT LAT. 40°13'50.43923"N AND LONG. 110°29'48.25715"W USING THE UTAH STATE G.P.S. VIRTUAL REFERENCE STATION CONTROL NETWORK MAINTAINED AND OPERATED BY THE AUTOMATED GEOGRAPHIC REFERENCE CENTER

PIPELINE AS-BUILT SURVEY FOR

KINDER MORGAN ALTAMONT, LLC.

TAYLOR 3-34C6

SECTION 34, T3S, R6W, U.S.B.&M.

DUCHESNE COUNTY, UTAH

LINE	BEARING	DISTANCE
L1	S 63°35'17" W	43.52'
L2	S 49°38'38" W	76.04'
L3	S 44°11'55" W	18.35'
L4	S 55°48'43" W	32.44'
L5	S 46°58'23" W	68.04'
L6	S 21°40'32" W	15.82'
L7	S 09°31'25" W	37.12'
L8	S 01°01'10" E	144.00'
L9	S 02°03'35" W	133.86'
L10	S 01°40'25" E	111.66'
L11	S 03°13'08" E	76.40'
L12	S 06°47'37" E	64.18'
L13	S 26°53'31" E	34.18'
L14	S 57°38'50" E	24.28'
L15	S 46°46'14" E	7.55'
L16	N 71°05'51" E	28.68'
L17	N 64°52'00" E	128.06'
L18	N 72°41'24" E	425.85'
L19	N 79°39'28" E	221.49'
L20	N 74°50'01" E	216.81'
L21	N 68°22'42" E	64.03'
L22	N 73°16'48" E	202.65'
L23	N 65°52'22" E	90.21'
L24	N 60°37'34" E	73.11'
L25	N 78°29'05" E	52.23'
L26	S 78°54'56" E	54.56'
L27	S 72°16'54" E	155.74'
L28	S 64°21'07" E	92.40'
L29	S 50°34'51" E	173.45'
L30	S 47°34'56" E	150.49'
L31	S 53°16'41" E	138.19'
L32	S 60°41'03" E	103.26'
L33	S 16°40'55" E	143.22'
L34	S 02°09'08" E	57.73'
L35	S 12°46'57" W	48.56'
L36	S 77°03'25" E	7.17'

SURVEYOR'S CERTIFICATE

This is to certify that this plat was prepared from the field notes and electronic data collector files of an actual survey made by me, or under my personal supervision, of the pipeline shown hereon, and that this plat accurately represents said survey to the best of my knowledge.

PROFESSIONAL LAND SURVEYOR No. 148951 JERRY D. ALLRED 15 NOV '13 STATE OF UTAH

JERRY D. ALLRED, REGISTERED LAND SURVEYOR, CERTIFICATE NO. 148951 (UTAH)

JERRY D. ALLRED AND ASSOCIATES
SURVEYING CONSULTANTS
1235 NORTH 700 EAST--P.O. BOX 975
DUCHESNE, UTAH 84021
(435) 738-5352

15 NOV 2013 12-121-080

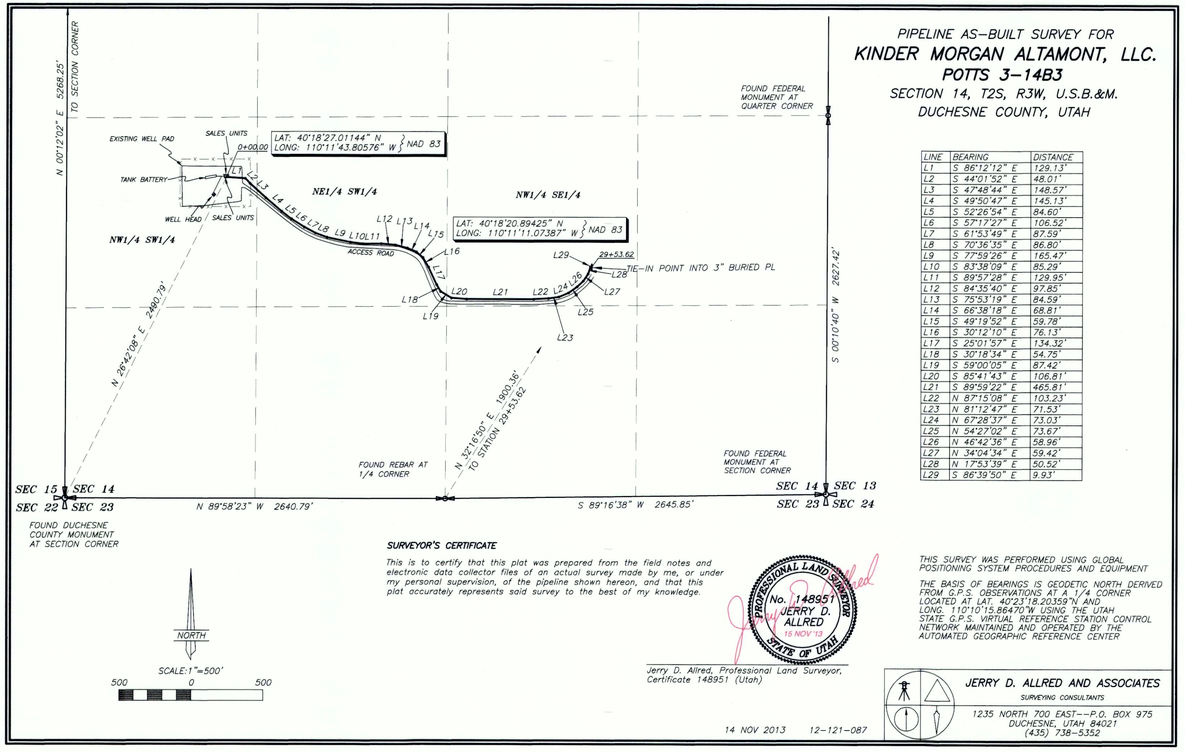

PIPELINE AS-BUILT SURVEY FOR

KINDER MORGAN ALTAMONT, LLC.

POTTS 3-14B3

SECTION 14, T2S, R3W, U.S.B.&M.

DUCHESNE COUNTY, UTAH

LINE	BEARING	DISTANCE
L1	S 86°12'12" E	129.13'
L2	S 44°01'52" E	48.01'
L3	S 47°48'44" E	148.57'
L4	S 49°50'47" E	145.13'
L5	S 52°26'54" E	84.60'
L6	S 57°17'27" E	106.52'
L7	S 61°53'49" E	87.59'
L8	S 70°36'35" E	86.80'
L9	S 77°59'26" E	165.47'
L10	S 83°38'09" E	85.29'
L11	S 89°57'28" E	129.95'
L12	S 84°35'40" E	97.85'
L13	S 75°53'19" E	84.59'
L14	S 66°38'18" E	68.81'
L15	S 49°19'52" E	59.78'
L16	S 30°12'10" E	76.13'
L17	S 25°01'57" E	134.32'
L18	S 30°18'34" E	54.75'
L19	S 59°00'05" E	87.42'
L20	S 85°41'43" E	106.81'
L21	S 89°59'22" E	465.81'
L22	N 87°15'08" E	103.23'
L23	N 81°12'47" E	71.53'
L24	N 67°28'37" E	73.03'
L25	N 54°27'02" E	73.67'
L26	N 46°42'36" E	58.96'
L27	N 34°04'34" E	59.42'
L28	N 17°53'39" E	50.52'
L29	S 86°39'50" E	9.93'

THIS SURVEY WAS PERFORMED USING GLOBAL POSITIONING SYSTEM PROCEDURES AND EQUIPMENT

THE BASIS OF BEARINGS IS GEODETIC NORTH DERIVED FROM G.P.S. OBSERVATIONS AT A 1/4 CORNER LOCATED AT LAT. 40°23'18.20359"N AND LONG. 110°10'15.86470"W USING THE UTAH STATE G.P.S. VIRTUAL REFERENCE STATION CONTROL NETWORK MAINTAINED AND OPERATED BY THE AUTOMATED GEOGRAPHIC REFERENCE CENTER

SURVEYOR'S CERTIFICATE

This is to certify that this plat was prepared from the field notes and electronic data collector files of an actual survey made by me, or under my personal supervision, of the pipeline shown hereon, and that this plat accurately represents said survey to the best of my knowledge.

PROFESSIONAL LAND SURVEYOR No. 148951 JERRY D. ALLRED 15 NOV '13 STATE OF UTAH

Jerry D. Allred, Professional Land Surveyor, Certificate 148951 (Utah)

JERRY D. ALLRED AND ASSOCIATES
SURVEYING CONSULTANTS
1235 NORTH 700 EAST--P.O. BOX 975
DUCHESNE, UTAH 84021
(435) 738-5352

14 NOV 2013 12-121-087

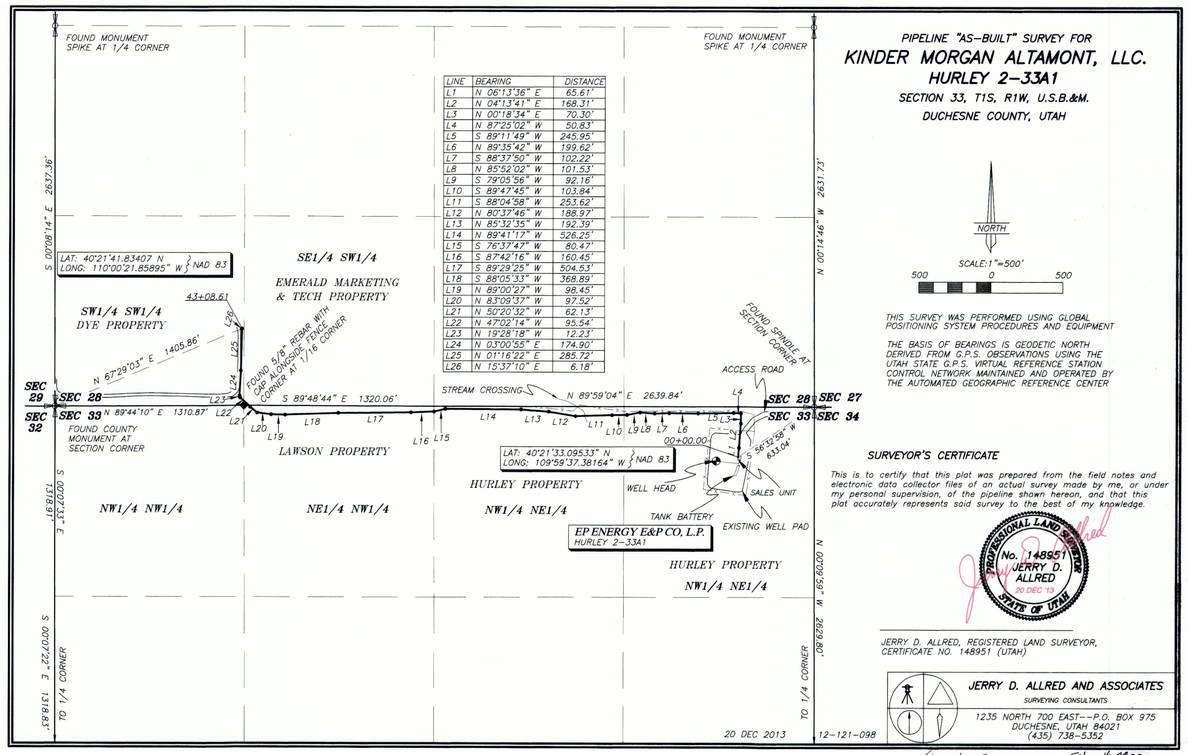

LINE	BEARING	DISTANCE
L1	N 06°13'36" E	65.61'
L2	N 04°13'41" E	168.31'
L3	N 00°18'34" E	70.30'
L4	N 87°25'02" W	50.83'
L5	S 89°11'49" W	245.95'
L6	N 89°35'42" W	199.62'
L7	S 88°37'50" W	102.22'
L8	N 85°52'02" W	101.53'
L9	S 79°05'56" W	92.16'
L10	S 89°47'45" W	103.84'
L11	S 88°04'58" W	253.62'
L12	N 80°37'46" W	188.97'
L13	N 85°32'35" W	192.39'
L14	N 89°41'17" W	526.25'
L15	S 76°37'47" W	80.47'
L16	S 87°42'16" W	160.45'
L17	S 89°29'25" W	504.53'
L18	S 88°05'33" W	368.89'
L19	N 89°00'27" W	98.45'
L20	N 83°09'37" W	97.52'
L21	N 50°20'32" W	62.13'
L22	N 47°02'14" W	95.54'
L23	N 19°28'18" W	12.23'
L24	N 03°05'55" E	174.90'
L25	N 01°16'22" E	285.72'
L26	N 15°37'10" E	6.18'

PIPELINE "AS-BUILT" SURVEY FOR

KINDER MORGAN ALTAMONT, LLC.

HURLEY 2-33A1

SECTION 33, T1S, R1W, U.S.B.&M.

DUCHESNE COUNTY, UTAH

THIS SURVEY WAS PERFORMED USING GLOBAL POSITIONING SYSTEM PROCEDURES AND EQUIPMENT

THE BASIS OF BEARINGS IS GEODETIC NORTH DERIVED FROM G.P.S. OBSERVATIONS USING THE UTAH STATE G.P.S. VIRTUAL REFERENCE STATION CONTROL NETWORK MAINTAINED AND OPERATED BY THE AUTOMATED GEOGRAPHIC REFERENCE CENTER

SURVEYOR'S CERTIFICATE

This is to certify that this plat was prepared from the field notes and electronic data collector files of an actual survey made by me, or under my personal supervision, of the pipeline shown hereon, and that this plat accurately represents said survey to the best of my knowledge.

PROFESSIONAL LAND SURVEYOR No. 148951 JERRY D. ALLRED 20 DEC '13 STATE OF UTAH

JERRY D. ALLRED, REGISTERED LAND SURVEYOR, CERTIFICATE NO. 148951 (UTAH)

JERRY D. ALLRED AND ASSOCIATES
SURVEYING CONSULTANTS
1235 NORTH 700 EAST--P.O. BOX 975
DUCHESNE, UTAH 84021
(435) 738-5352

20 DEC 2013 12-121-098

County Surveyors File # 2932